

See Cr.
to Bel: 16/2/87.

11. 2. 87.
Hamm.



Not fitted thus
at first. as approved
J.S.
Belfast
15.2.87

9/s. 11.2.28


Seate 1/2 - 1 foot.



Lloyd's Register
Foundation

BEL 54-0273 (1/2)

22 Nov 28
 22 Nov 28

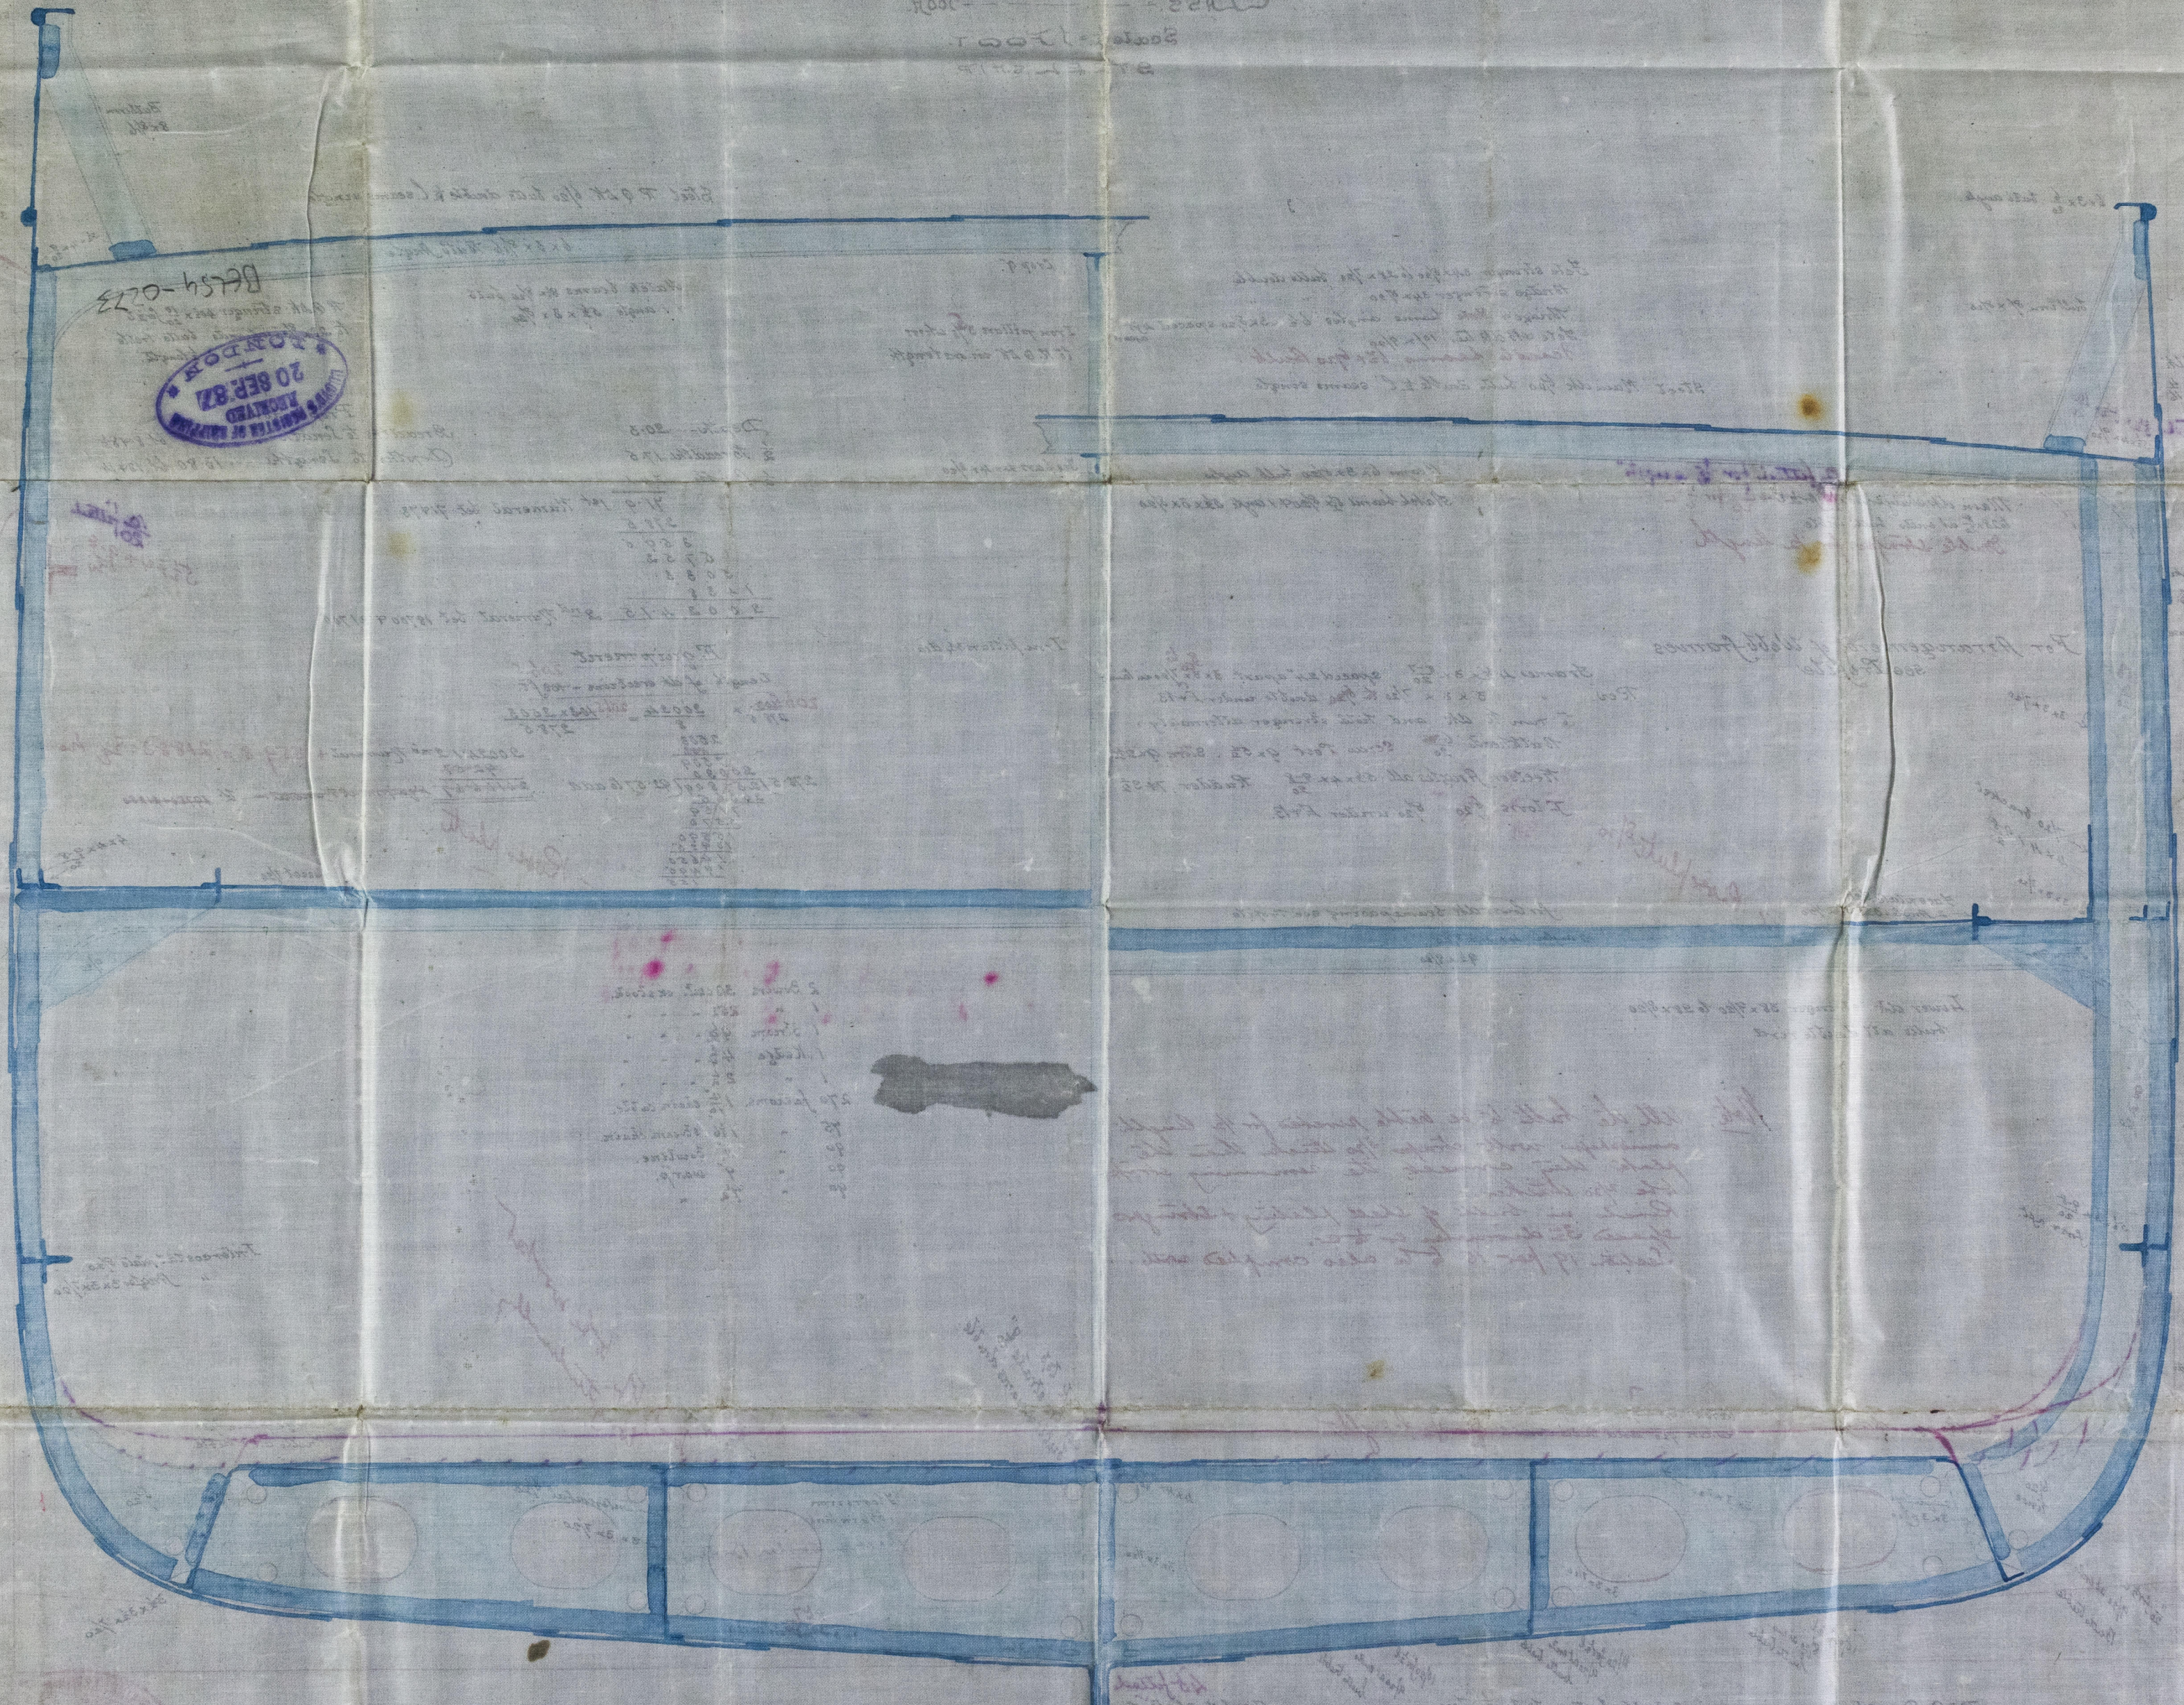


20 DEC 28


20. 1. 87.

S. S. ¹⁰⁰Titanic
Belfast Reports N^o 3416 (Freeboard)

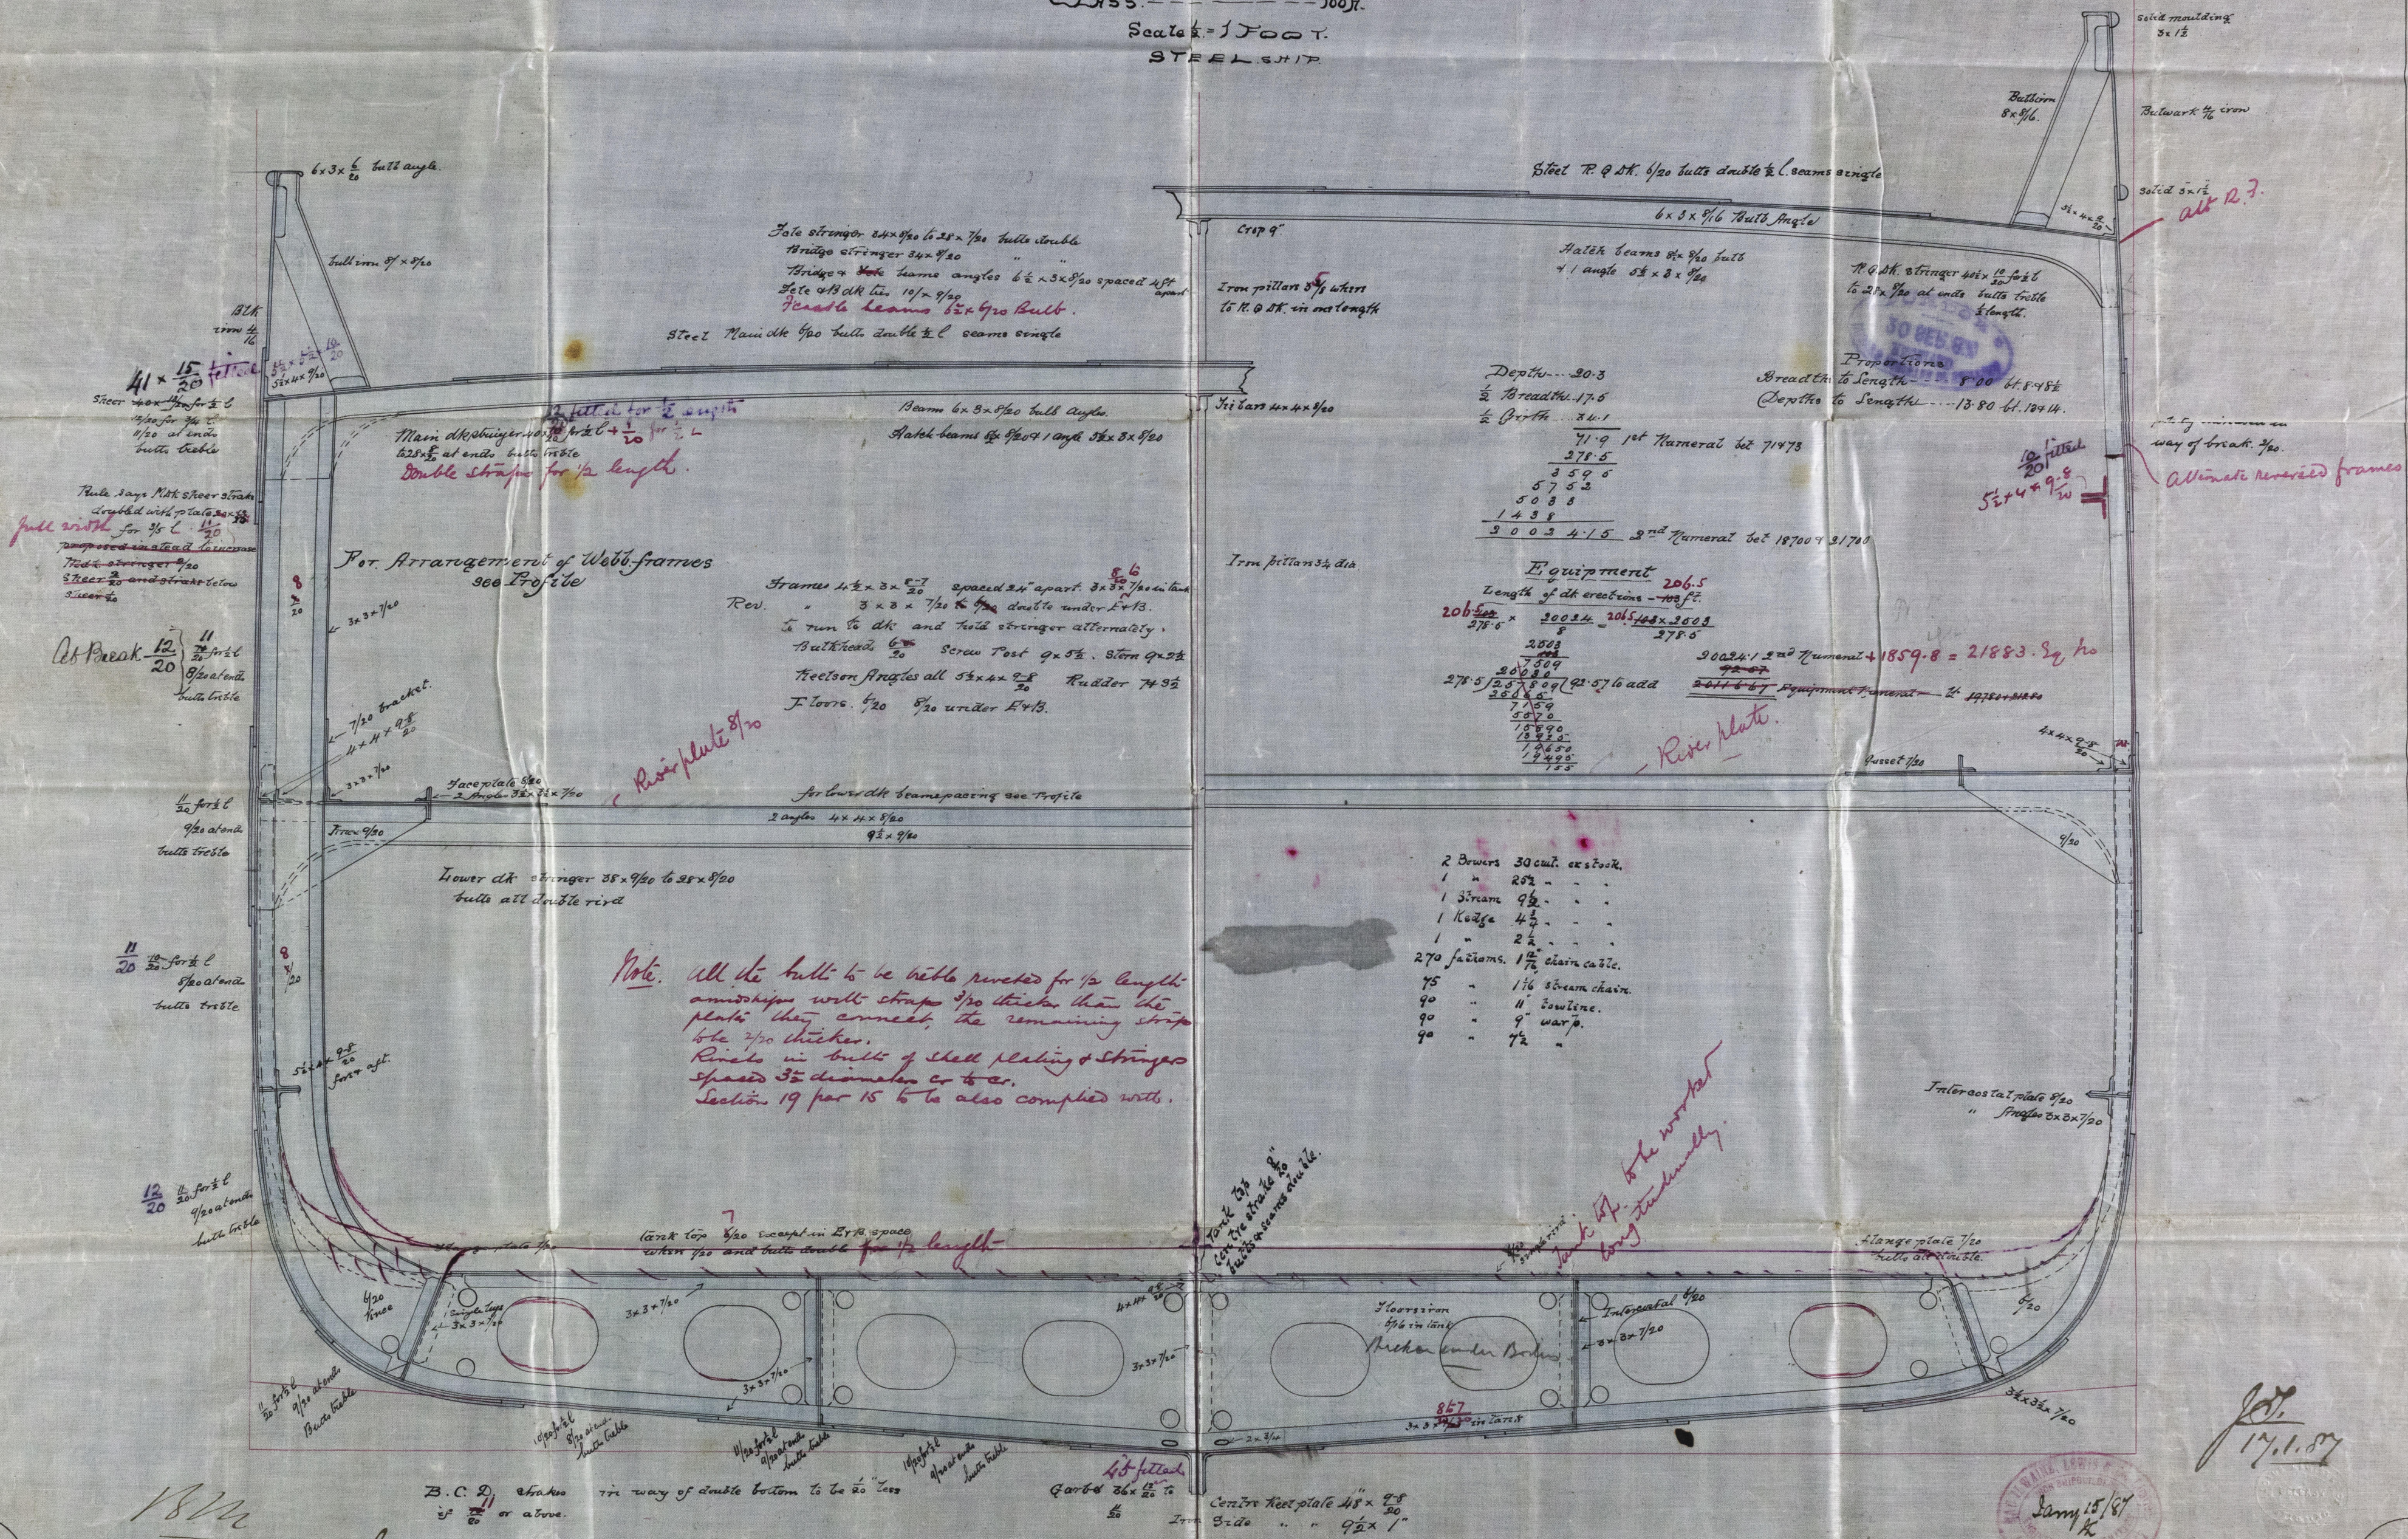

Depth of double bottoms
increased from 3.3 to 3.9
Feb 4-5

Jan 15/87
K

© 2019

Lloyd's Register
Foundation

BELSH - 0273 (2/2)