

Lloyd's Register of British and Foreign Shipping.

(Report on Vessel No. 198 Port Belfast)

No. 1245 SHIP FORGINGS OR CASTINGS.

I have to report that the undermentioned Iron ~~or Steel~~ Forgings ~~or Castings~~, manufactured by The Lancefield Forge Co of Glasgow for the Vessel No. 198, being built by Messrs Harland and Wolff of Belfast, have been inspected by me as set forth below, and found to be, so far as can be seen, sound and efficient.

The words FORGINGS or CASTINGS, IRON or STEEL, should be struck out as may be required.


Mark on Forgings.

Lloyd's
No. 1245
G. N.

George Newcomb.
Glasgow 2/10/86.

	STERN FRAME.	RUDDER FRAME.	STEM & Keel
Material*	<u>Scrap iron</u>	/	<u>Scrap iron</u>
How made	<u>Forged</u>		<u>Forged</u>
Dimensions	<u>11 x 6 1/2</u>		<u>9 x 3 3/8</u>
Progress on Inspection .	<u>Forging & smithing</u>		<u>Forging</u>
Dates when Inspected	<u>5.9.13/8/86.</u> <u>1.4.7.9.13.16.18.21.24.25.29/9/86.</u>		<u>31/7/86.3.5.9.13/8/86.</u>

SKETCHES OF FRAMES SHEWING POSITION AND DESCRIPTION OF WELDS OF FORGINGS, OR PARTICULARS OF TESTS APPLIED TO CASTINGS.

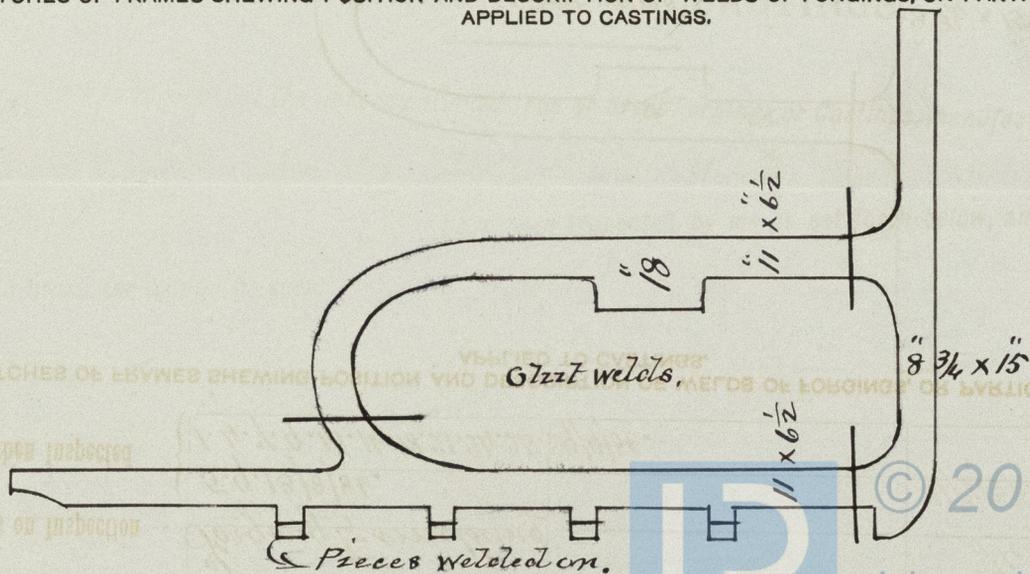

* If of Iron, state whether scrap or puddled iron.

No. 198
Forgings of Stern Frame &
Stern & Keel
Belfast - Oct. 21th /86

S. S. Lycia
Belfast Report
No. 3423

Register of British and Foreign Shipping

SHIP FORGINGS OR CASTINGS

I have to report that the undermentioned Iron or Steel Forgings or Castings, manufactured by

have been inspected by me as set forth below and found

to be so far as can be seen

© 2019

Lloyd's Register
Foundation

