

Horizon Rep. Report 3425 Received at Belfast Office, Mar 21st 1888

Lloyd's Register of British and Foreign Shipping.

(Report on Vessel No. 7 Port Belfast)

No. 1660

SHIP FORGINGS OR CASTINGS.

I have to report that the undermentioned Iron or ~~Steel~~ Forgings or Castings, manufactured by

The Irvine Forge Co. of Irvine.

for the Vessel No. 7, being built by Mr G. J. Bigger.

of Londonderry. have been inspected by me as set forth below, and found

to be, so far as can be seen, sound and efficient.

The words FORGINGS or CASTINGS, IRON or STEEL, should be struck out as may be required.

Mark on Forgings.

Lloyd's
No. 1660
G.N

George Newcomb.



Glasgow.

20/3/88.

Post

	STERN FRAME.	RUDDER FRAME.	STEM.
Material*	<u>Scrap iron</u>	<u>Scrap iron</u>	/
How made	<u>Forged.</u>	<u>Forged.</u>	
Dimensions	<u>4 1/2 x 2 3/8.</u>	<u>5 1/4 dia.</u>	
Progress on Inspection	<u>Completed</u>	<u>Forging & smithing</u>	
Dates when Inspected	<u>10/1/88.</u>	<u>28/2/88. 2.4.12.15.17/3/88.</u>	

SKETCHES OF FRAMES SHEWING POSITION AND DESCRIPTION OF WELDS OF FORGINGS, OR PARTICULARS OF TESTS APPLIED TO CASTINGS.

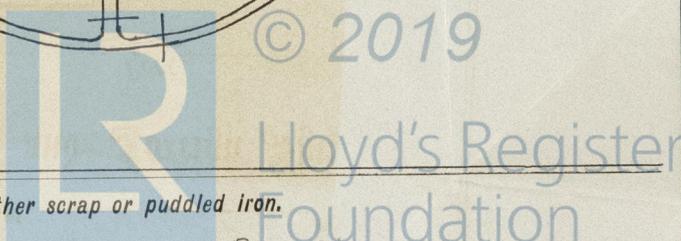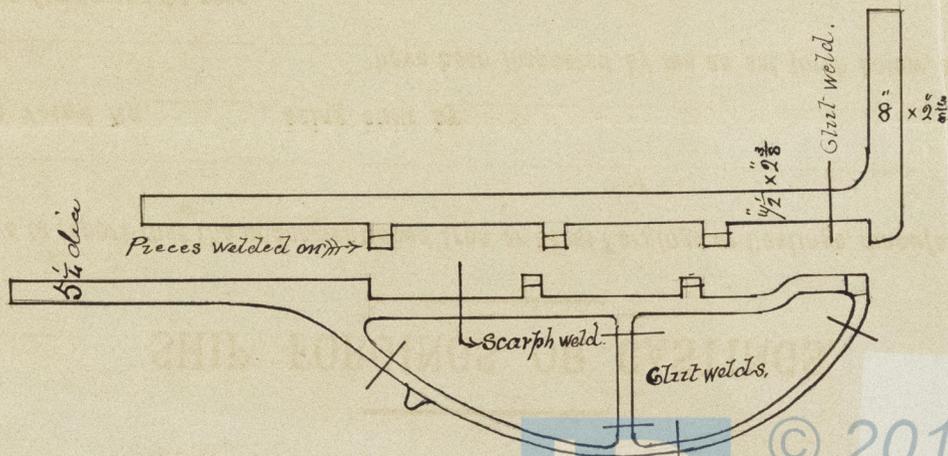

C. F. Biggers No. 4
Steer Post & Rudder
Forgings.

Bk. "Horizon"
Belfast Report
No. 3425



© 2019

Lloyd's Register
Foundation