

5.12.87.

BR "Horizon" Belfast Report  
 No 3425

Midship Section


Iron Barque No 7.

With Raised Quarter deck under  
 1/4 length.

Dimensions — Class 100 A1 at Lloyd's  
 Length B.P. — 200' 0"  
 Breadth M<sup>2</sup> — 33' 4"  
 Depth at Centre — 22' 2 1/2"  
 Depth of hold — 20' 0"  
 Scale 1/2" = one foot.

1/2 Girth 35.25  
 1/2 Breadth 16.95  
 Depth 22.20  
 Frame wt = 74.40 x 197.75 = 14712 + 15 = 15693

Proportions:  
 5.83 Breadths.  
 8.90 Depths.

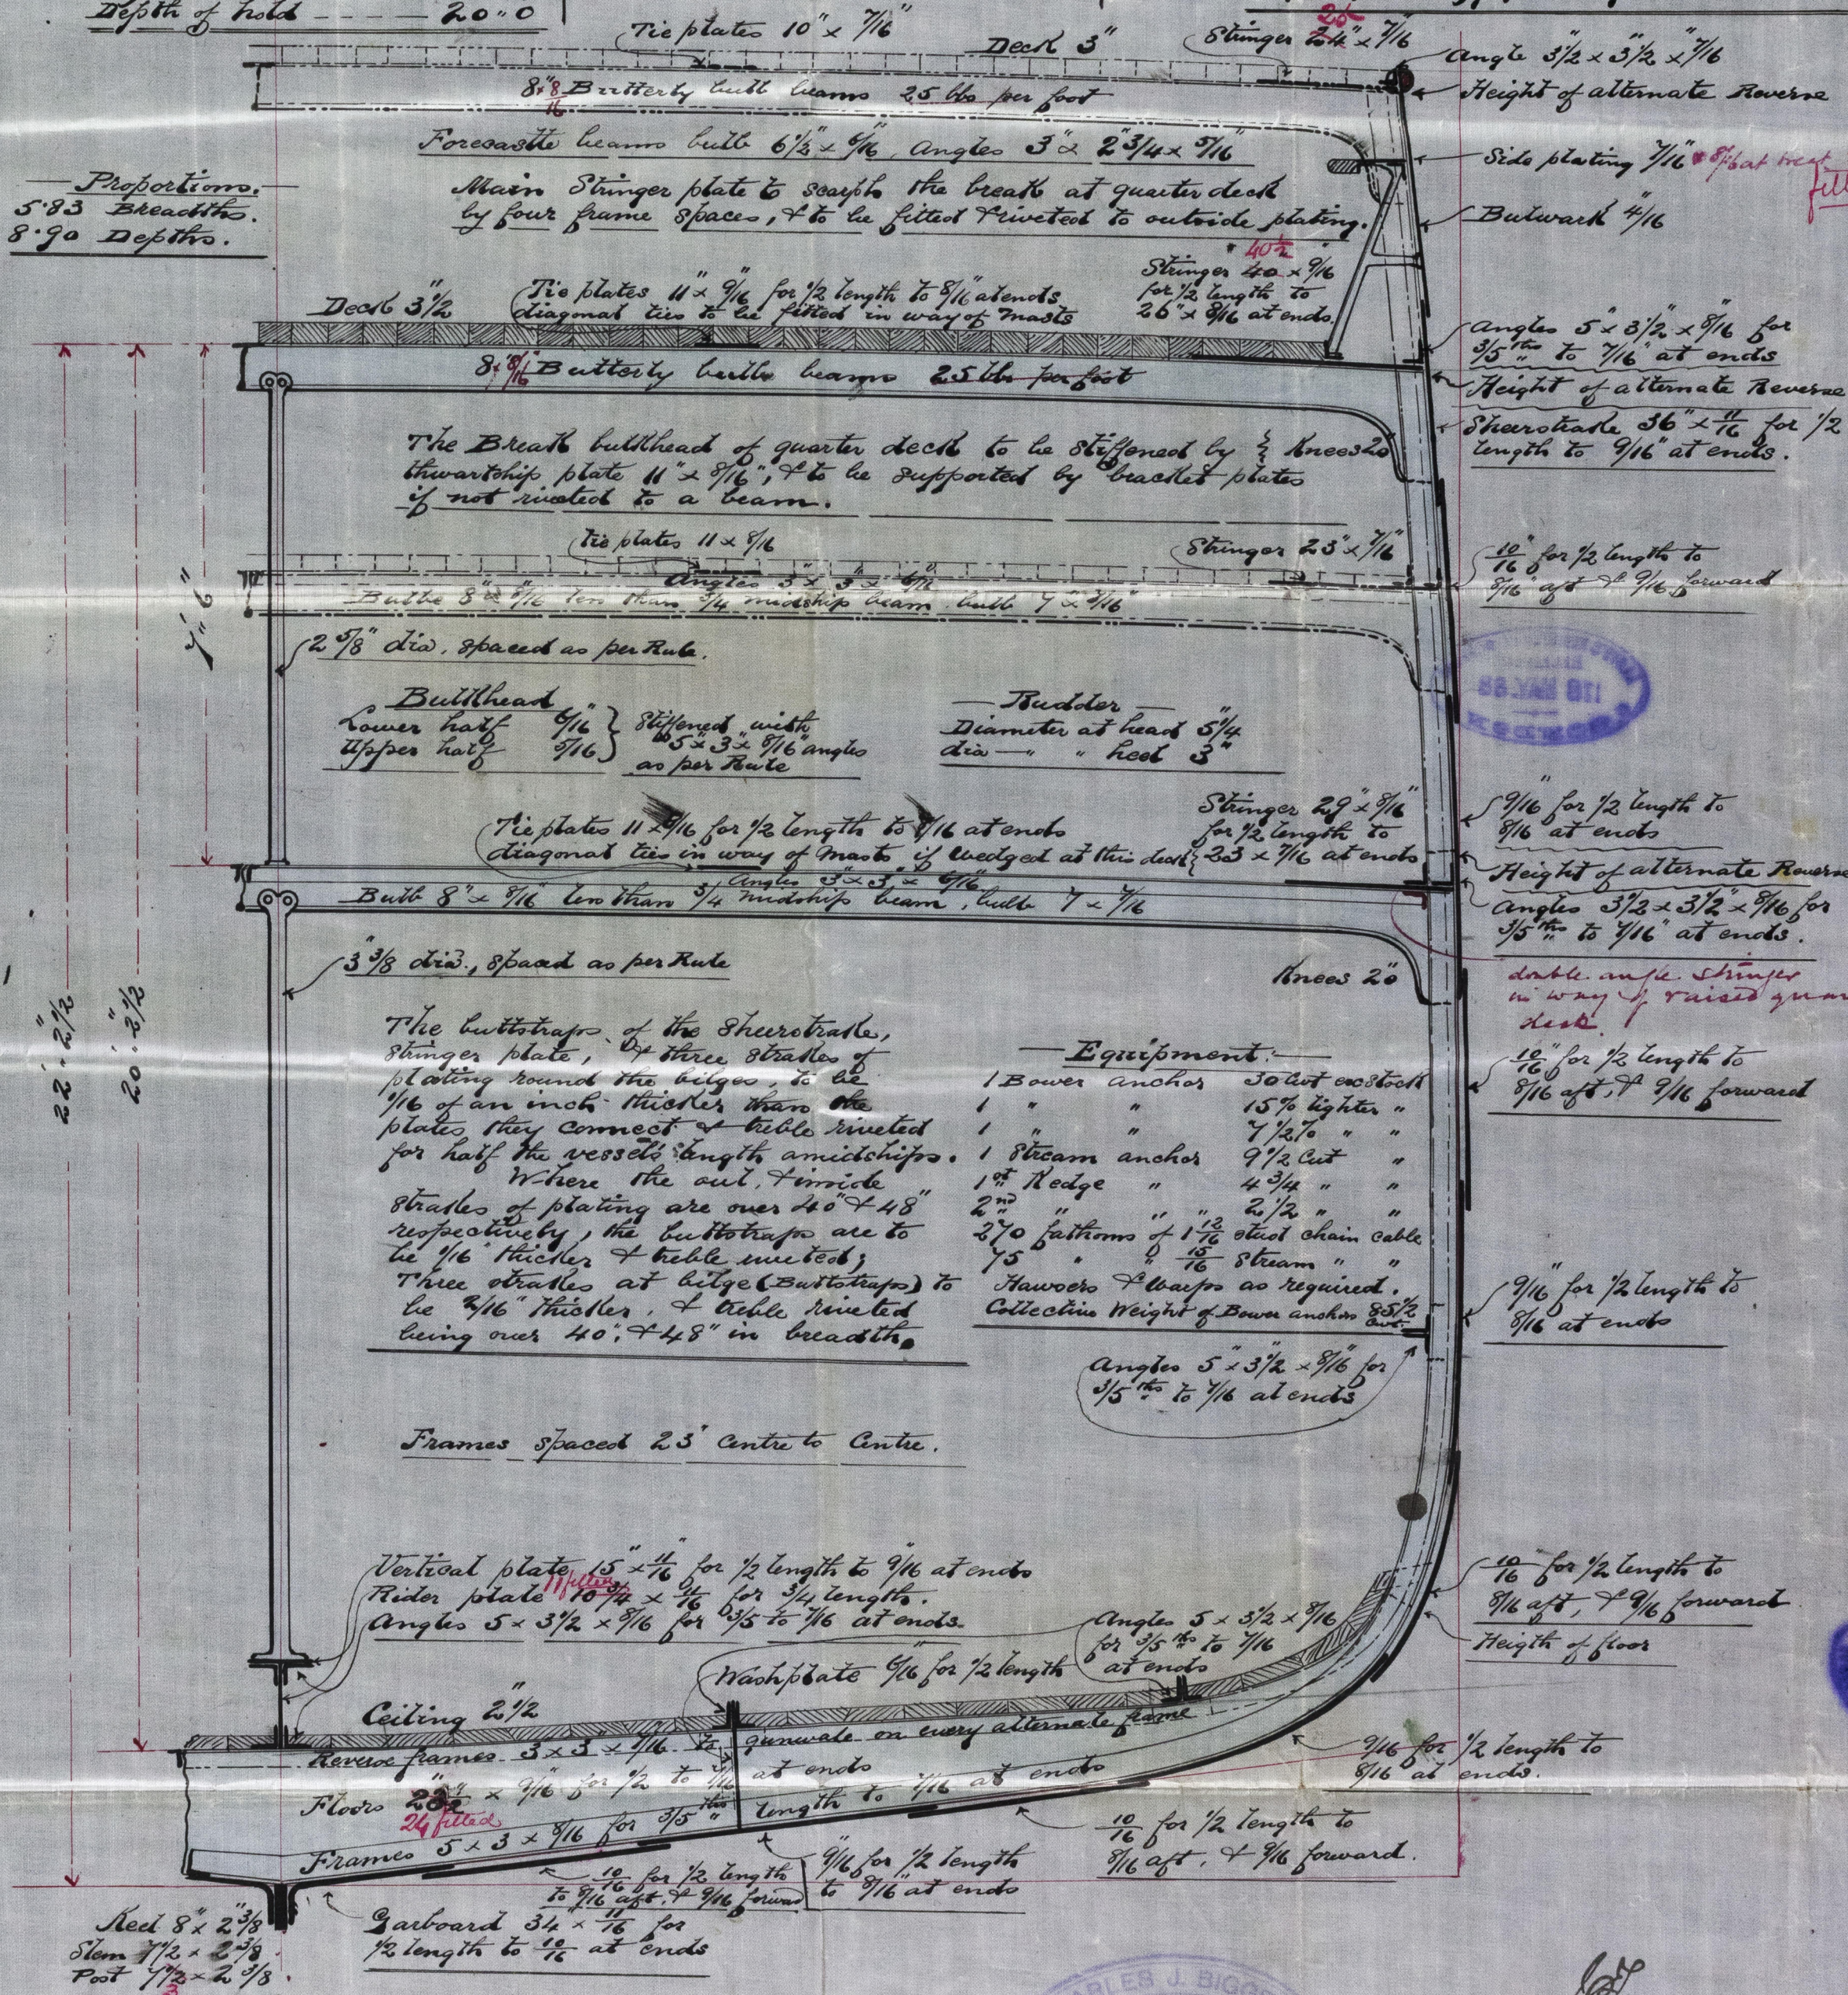

- Equipment.
- 1 Bower anchor 30 cwt cast steel
  - 1 " " 15% lighter "
  - 1 " " 7 1/2% " "
  - 1 Steam anchor 9 1/2 cwt "
  - 1st Redge " 4 3/4 " "
  - 2nd " " 2 1/2 " "
  - 270 fathoms of 1 1/2\"
  - 15 " of 1/2\"
  - Hawseers & Warps as required.
  - Collection Weight of Bower anchor 85 1/2

CHARLES J. BIGGER  
 SHIPBUILDER &  
 30 NOV 87  
 ENGINEER  
 LONDONDERRY

2.12.87



215.87






