




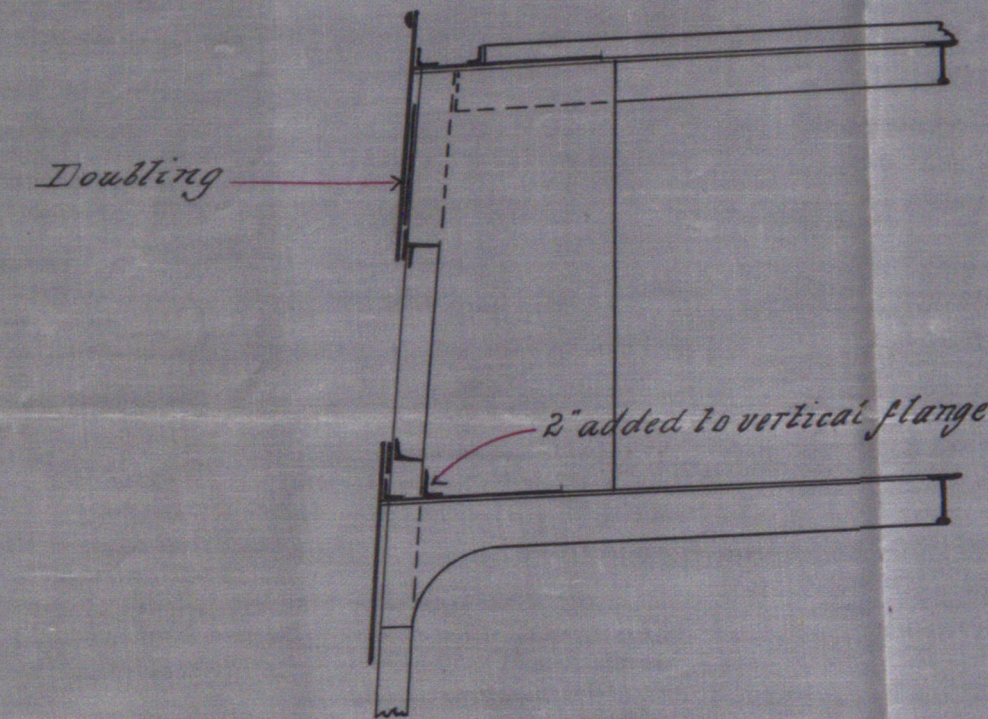

9/12/86

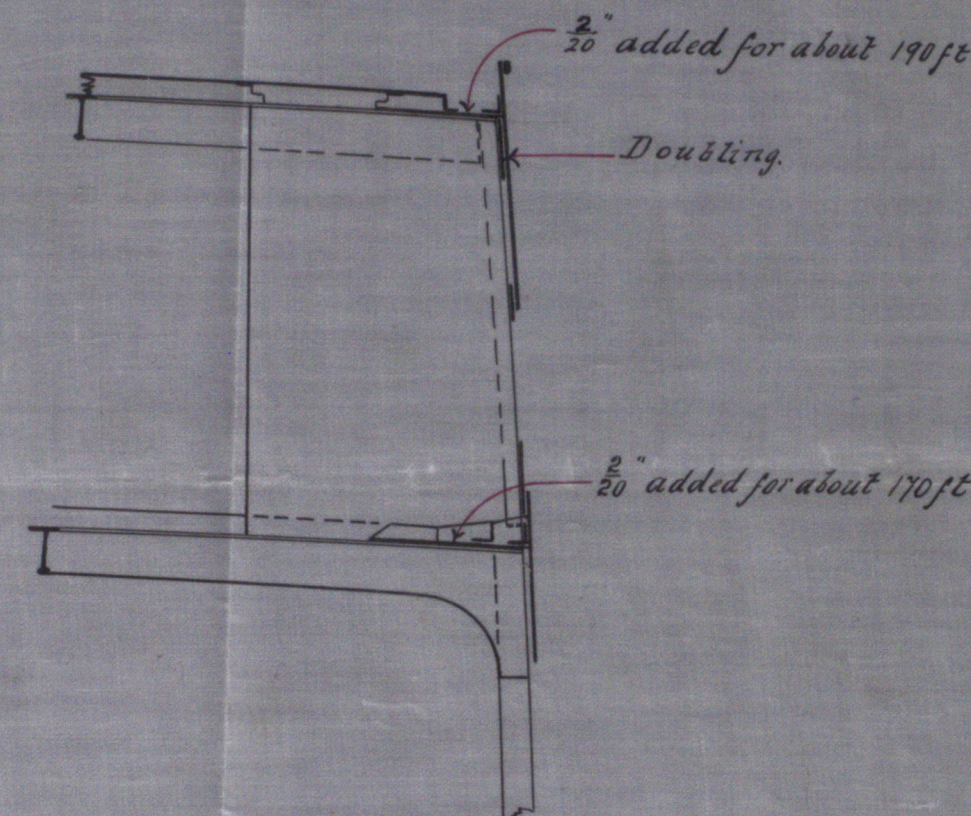

SECTION IN WAY OF CARGO PORT

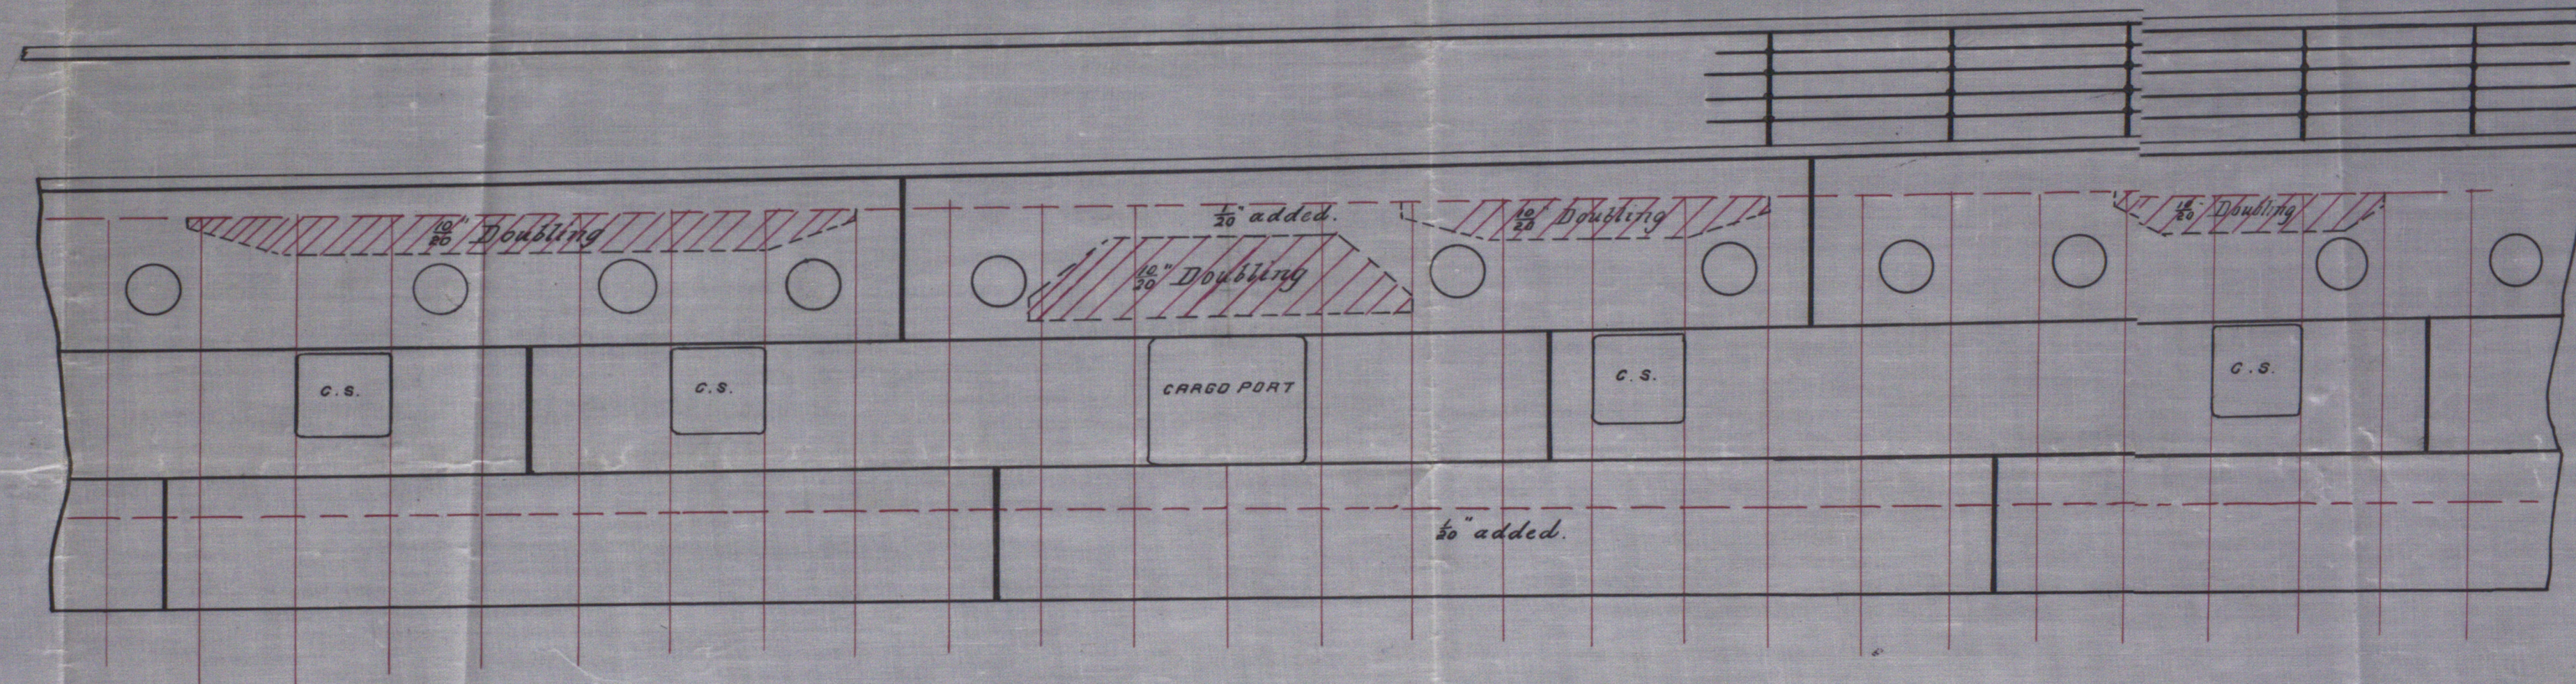

SECTION IN WAY OF COAL PORT

PROPOSED COMPENSATION FOR COAL

AND CARGO PORTS.

N<sup>o</sup> 201.


SCALE  $\frac{1}{4}$ " = ONE FOOT

S.S. Oceana  
Belfast Report  
N<sup>o</sup> 3402

J.H.  
9/12/86

S.S. Arcadia  
Belfast Report  
N<sup>o</sup> 3426

J.H.  
7.12.86

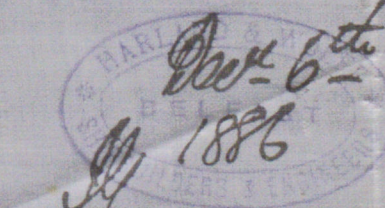

© 2019  
Lloyd's Register  
Foundation

136154-0317