

Ltr to Belfast
 22/11/86
 9/12/86

N^o 201.


BULKHEAD & PUMPING ARRANGEMENT

SCALE $\frac{1}{12}$ = ONE FOOT.


12 Nov
1886

S.S. "Oceana" Belfast Report No 3402
 S.S. "Arcadia" Belfast Report No 3426

Lift of back pumps from Rose box to pump bucket.
 not more than 24ft 6in.

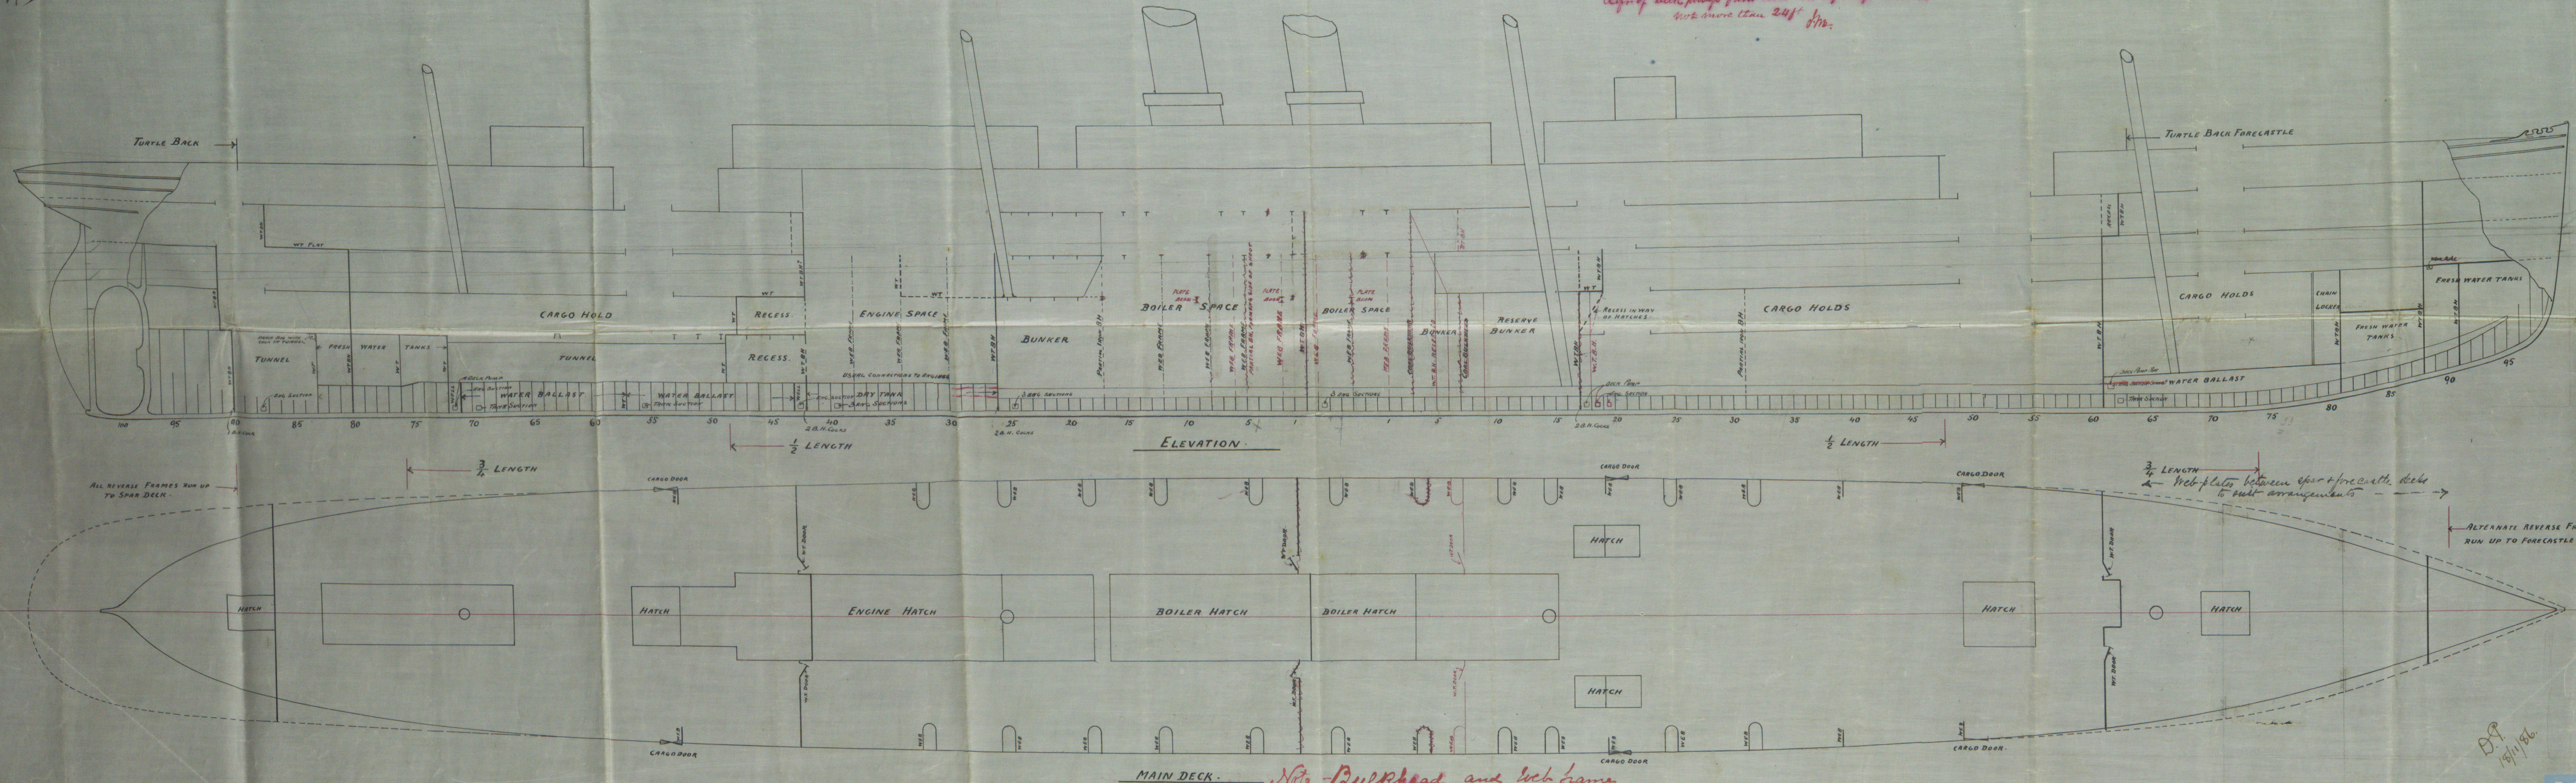

Note: Bulkhead and web frame
 arrangement in Boiler space
 revised Nov-27. 86

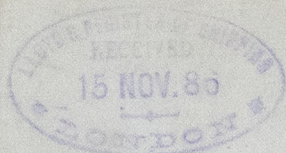

BELSH-0321

TURTLE BACK FORECASTLE



© 2019

Lloyd's Register
Foundation