

N. S. "Bostonian"
Belfast Report
No. 3464

MIDSHIP SECTION

STEEL S.S. 421'-10" x 43'-0" x 34'-6" KEEL TO BEAMS

Nº 204

TO CLASS 100A AT LLOYDS

THREE DECK RULE

SCALE $\frac{1}{2}'' = \text{ONE FOOT}$


NUMERALS

$$21.5 + 39.5 + 51.16 - 7 = 100.16 \quad \text{FRAMING No}$$
$$100.16 \times 412.83 = 42.050 \text{ PLATING NO}$$
$$107.16 \times 419.83 + 3639 = 48.628 \text{ EQUIPMENT NO}$$

9.7 BREADTHS TO LENGTH

12.1 DEPTHS TO UPPER DECK

15.6 DEPTHS TO MIDDLE DECK

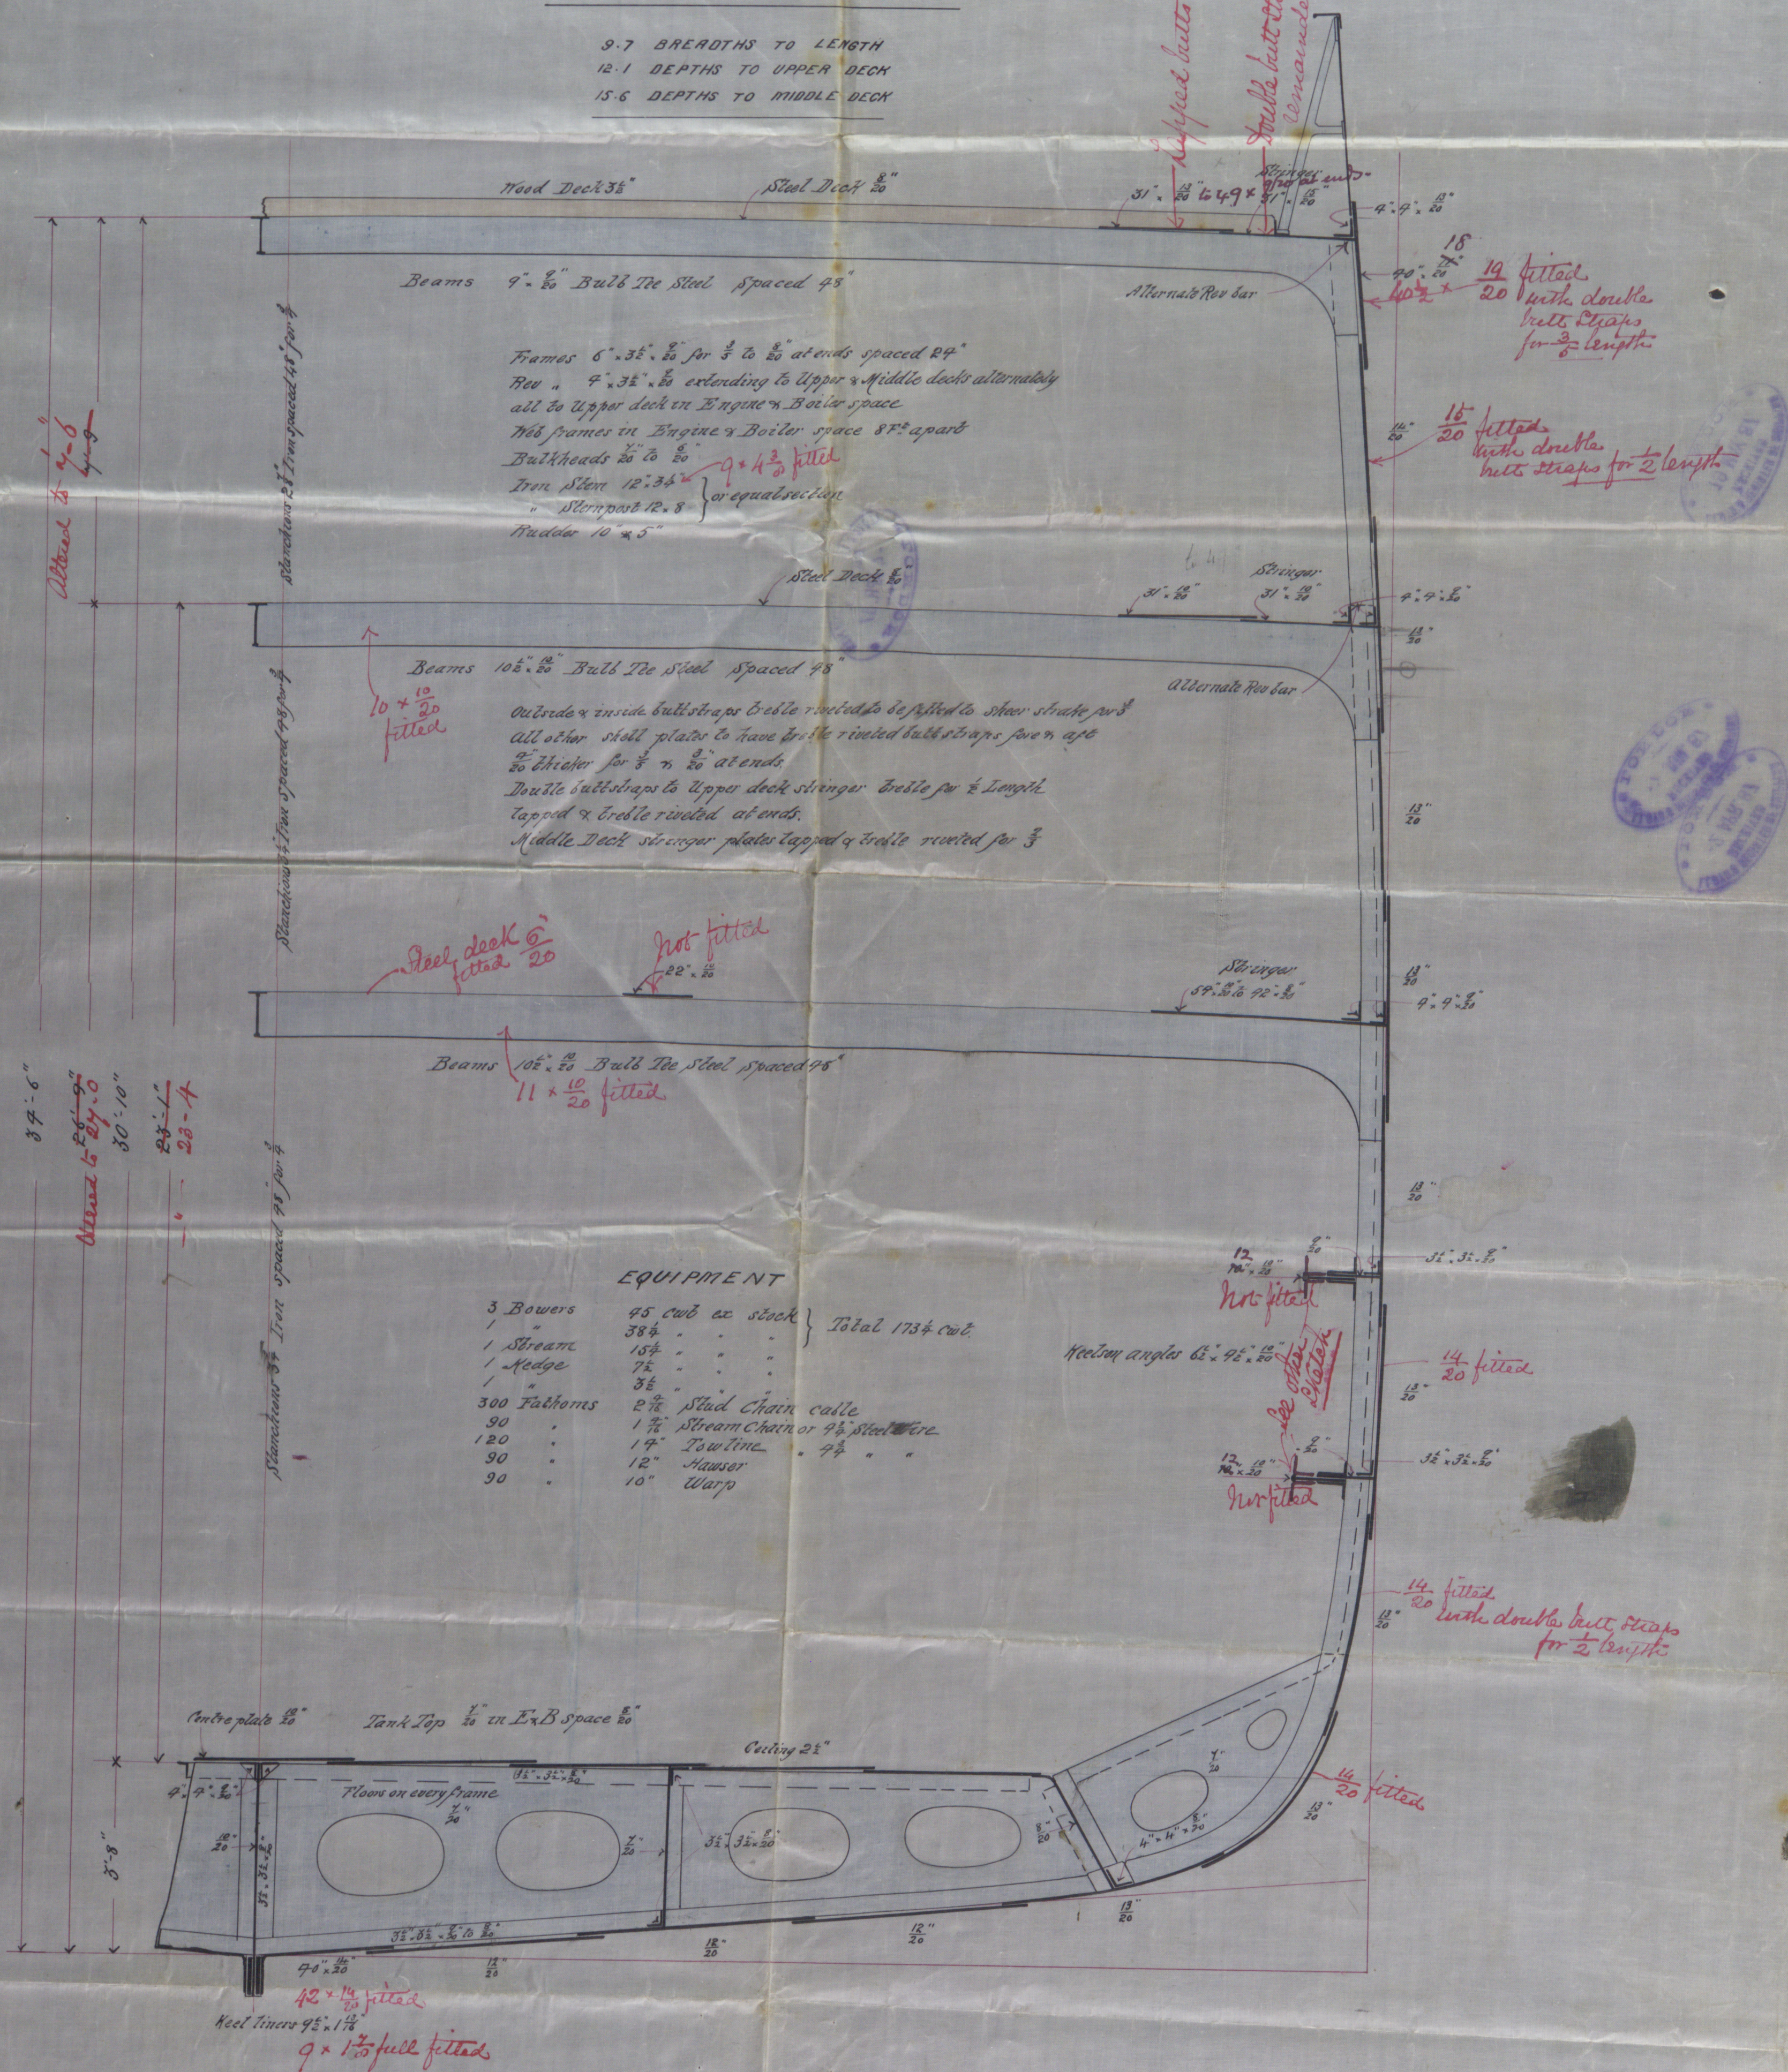

1876
 7/4/87
 1.4.87
 1876

LLOYD'S REGISTER OF SHIPPING
RECEIVED
-2 APR. 87
LONDON

LLOYD'S REGISTER OF SHIPPING
RECEIVED
-7 JUN. 87
LONDON

BELSS-0016

2 1/2"

4' 4 1/2"

2 1/2"

2' 0"

imposed
2 1/2"

2 1/2"

not off 24/11/87




LONDON
-4 APR. 87
RECEIVED