





5.5.87.

No. 204.

S. S. Bostonian
Belfast Report No. 3464


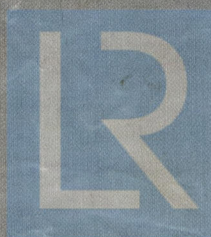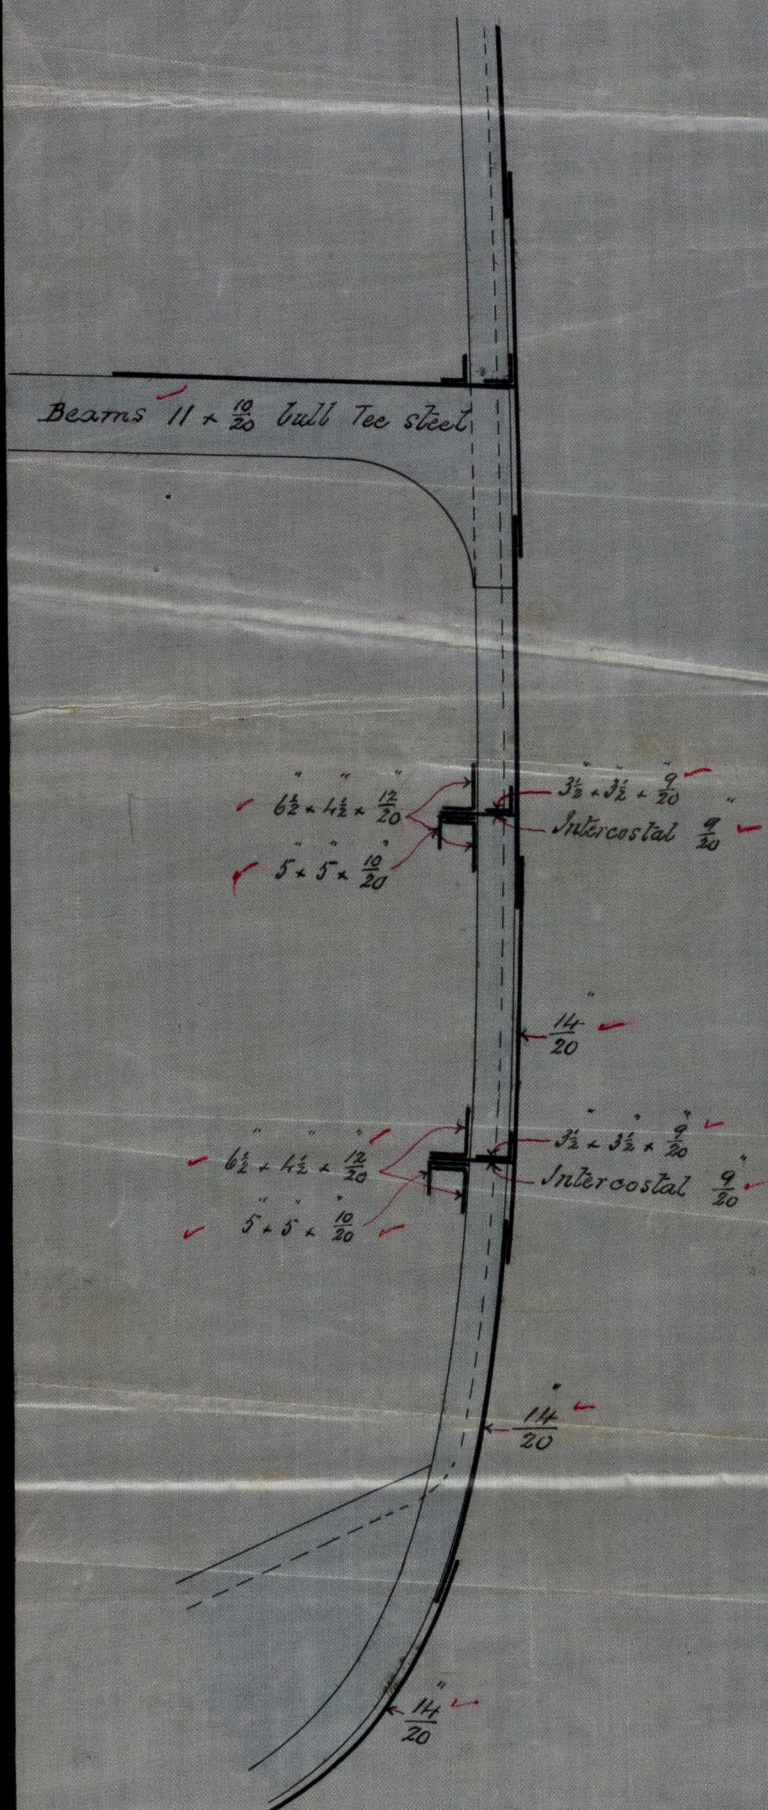

2019
30.4.87

Lloyd's Register
Foundation

BEL55-0017