


S.S. *Protonian*
Belfast Report No 3464

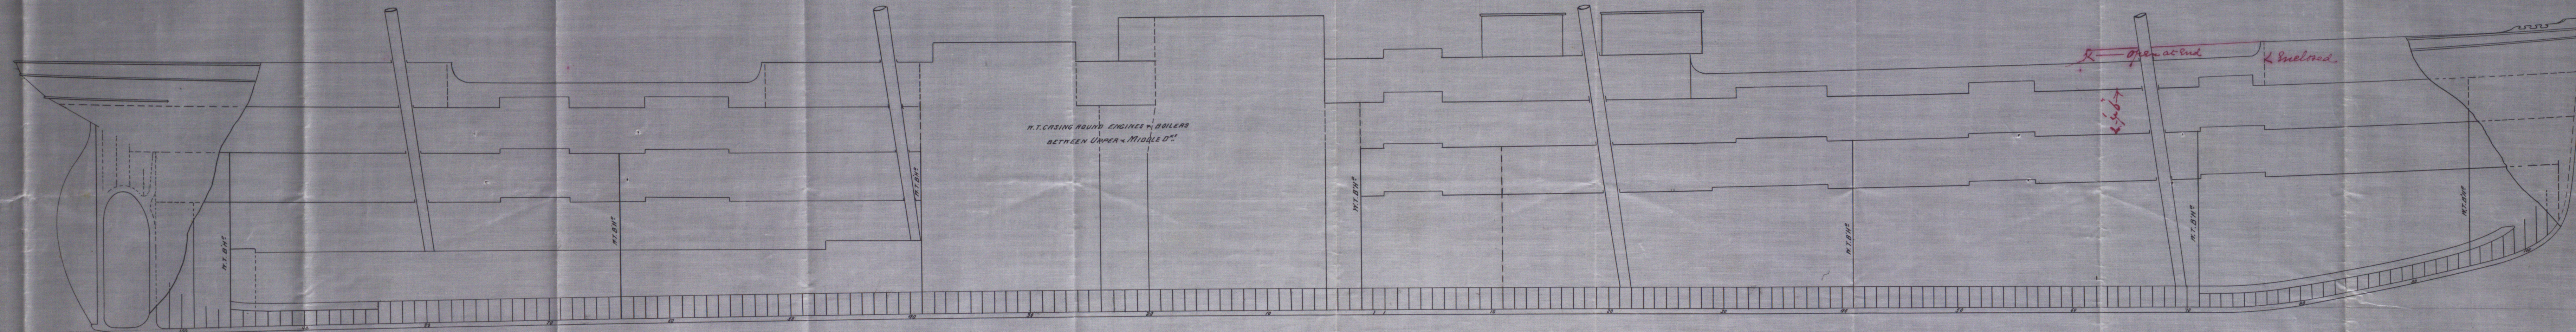

— No 207 —

— S.S. 421'10" x 43'0" x 34'6" KEEL TO BEAMS —

— BULKHEAD ARRANGEMENT —

— SCALE 1/12" = ONE FOOT —

July 25th
1884



30-7-87