

The words FORGINGS or CASTINGS, IRON or STEEL, should be struck out as may be required.

Received at Belfast Office, 15<sup>th</sup> Feb. 1888.

**Lloyd's Register of British and Foreign Shipping.**  
 (Report on Vessel No. 3471 Port Belfast Liverpool)  
14-2-88

No. 53 **SHIP FORGINGS OR CASTINGS.**

I have to report that the undermentioned Iron or ~~Steel~~ Forgings or ~~Castings~~, manufactured by The Mersey Forge Co of Liverpool for the Vessel No. 55, being built by Messrs. Withman Clark & Co of Belfast have been inspected by me as set forth below, and found to be, so far as can be seen, a good sound forging


Mark on Forgings.

**Lloyd's**  
 No. L. 86  
G. A. M.

Geo A. Milner  
Liverpool

	STERN FRAME.	RUDDER FRAME.	STEM.
Material*	<u>Scrap Iron</u>		
How made	<u>Forged</u>		
Dimensions	<u>9 x 5 1/2</u>		
Progress on Inspection	<u>Forging &amp; Finished</u>		
Dates when Inspected	<u>Jan 11<sup>th</sup> - 13<sup>th</sup> - 21<sup>st</sup> - Feb 10<sup>th</sup></u>		

SKETCHES OF FRAMES SHEWING POSITION AND DESCRIPTION OF WELDS OF FORGINGS, OR PARTICULARS OF TESTS APPLIED TO CASTINGS.

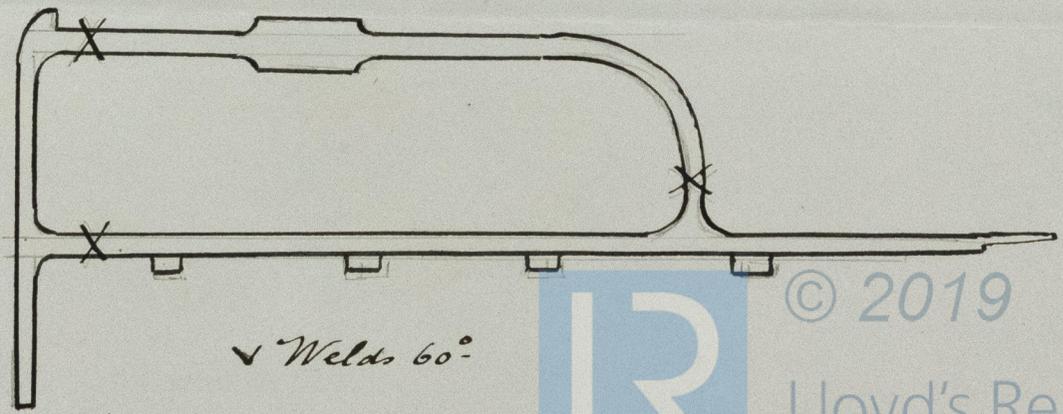

© 2019  
 Lloyd's Register  
 Foundation

\* If of Iron, state whether scrap or puddled Iron.

