

22.12.87.



S. S. Palmas  
Belfast Report No. 3492  
S. S. Lord Londonderry  
Belfast Report for Freeboard No. 3510  
And Tinsbury No. 3510



PROPOSED COMPENSATION FOR  
HOLD BEAMS

PROPOSED S.S. 312-0 x 39-0 x 28-3 KEEL TO BEAMS

SCALE  $\frac{1}{2}$  = ONE FOOT

No 212. and 213

Alternate Red bar

✓ All The Alternate Red bars to  
Upper & Middle decks in  
E & B space. or web frames  
to upper decks


As fitted


Alternate Red bar

+ NOTE It is proposed to retain one or two  
old seams at each end of vessel for planing and  
to fit the proposed arrangement between these  
points, dispensing with web frames in E & B space.

+ A longitudinal plan showing the  
disposition of beams should be  
submitted for the information  
and approval of the Committee.

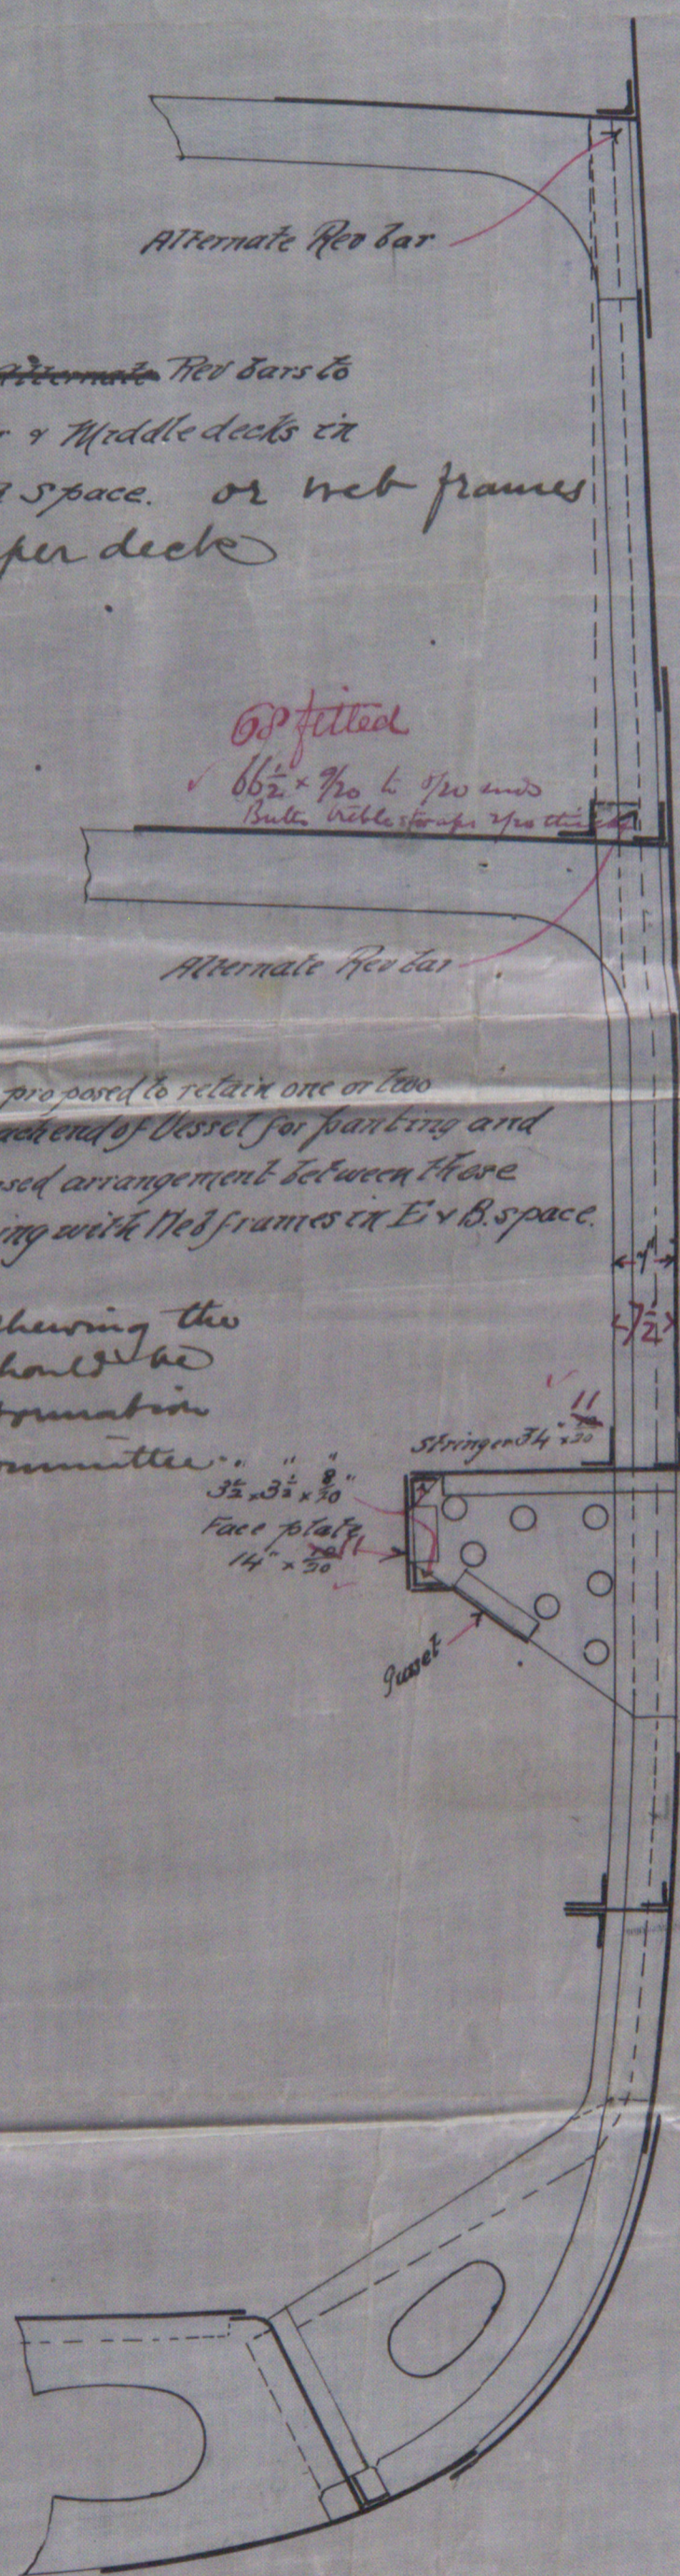

32 x 32 x 30

Face plate

14 x 30

Stringer 34 x 30

Gusset

Brackets 5" x 20" spaced 48"

Frames & Red frames 5" x 32 x 20

5 1/2 x 3 1/2 x 20

5 x 3 1/2 x 20

15/12/87

10.12.87