


Lth. 4/6/86
 6.7.88.

No. 212 S.S. and No. 213
 PUMPING ARRANGEMENT
 Scale $\frac{1}{12}$ = One Foot.

May 25th
 1888

S.S. "Palmas"
 Belfast Report No. 349.2

S.S. "Lord Londonderry"
 Belfast Report for Freeboard
 No. 3510
 And First Entry No. 3516

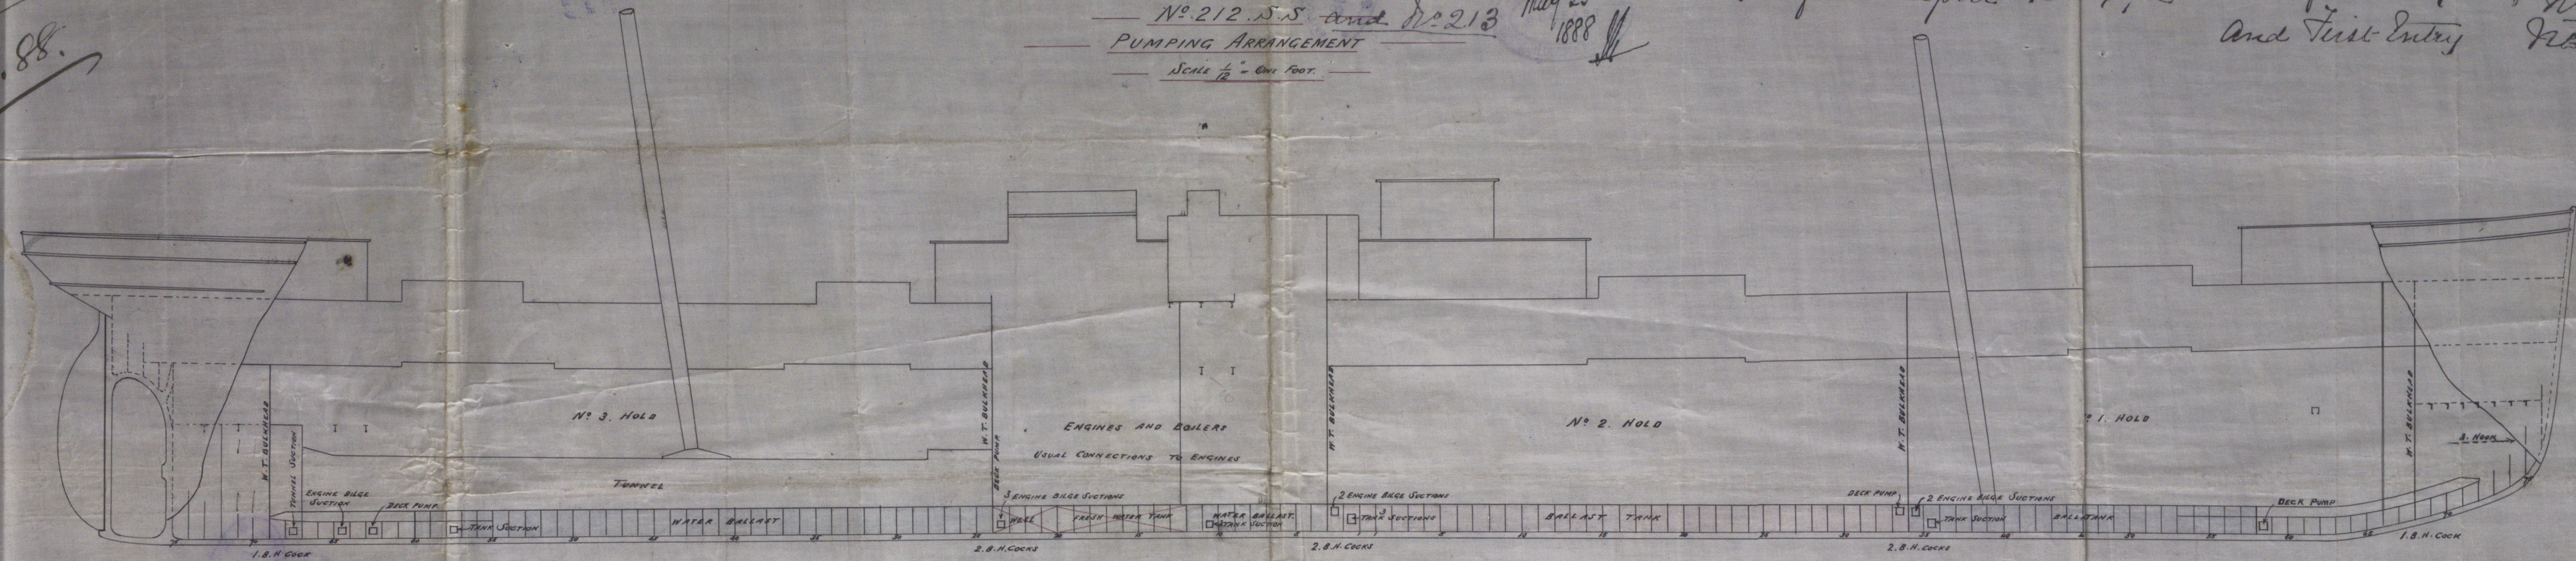

6/7/88

LLOYD'S REGISTER OF SHIPS
 25 JUL 88
 LONDON

31.5.88

26.5.88