

Tracing No. 2748

Alterations to Crown Stays


Scale 1" = One Foot.

Boilers Nos. 256-7.


Lt 25/4/88


S.S. "Palmas" Belfast Rep. No. 3492

Mr 30/4/88

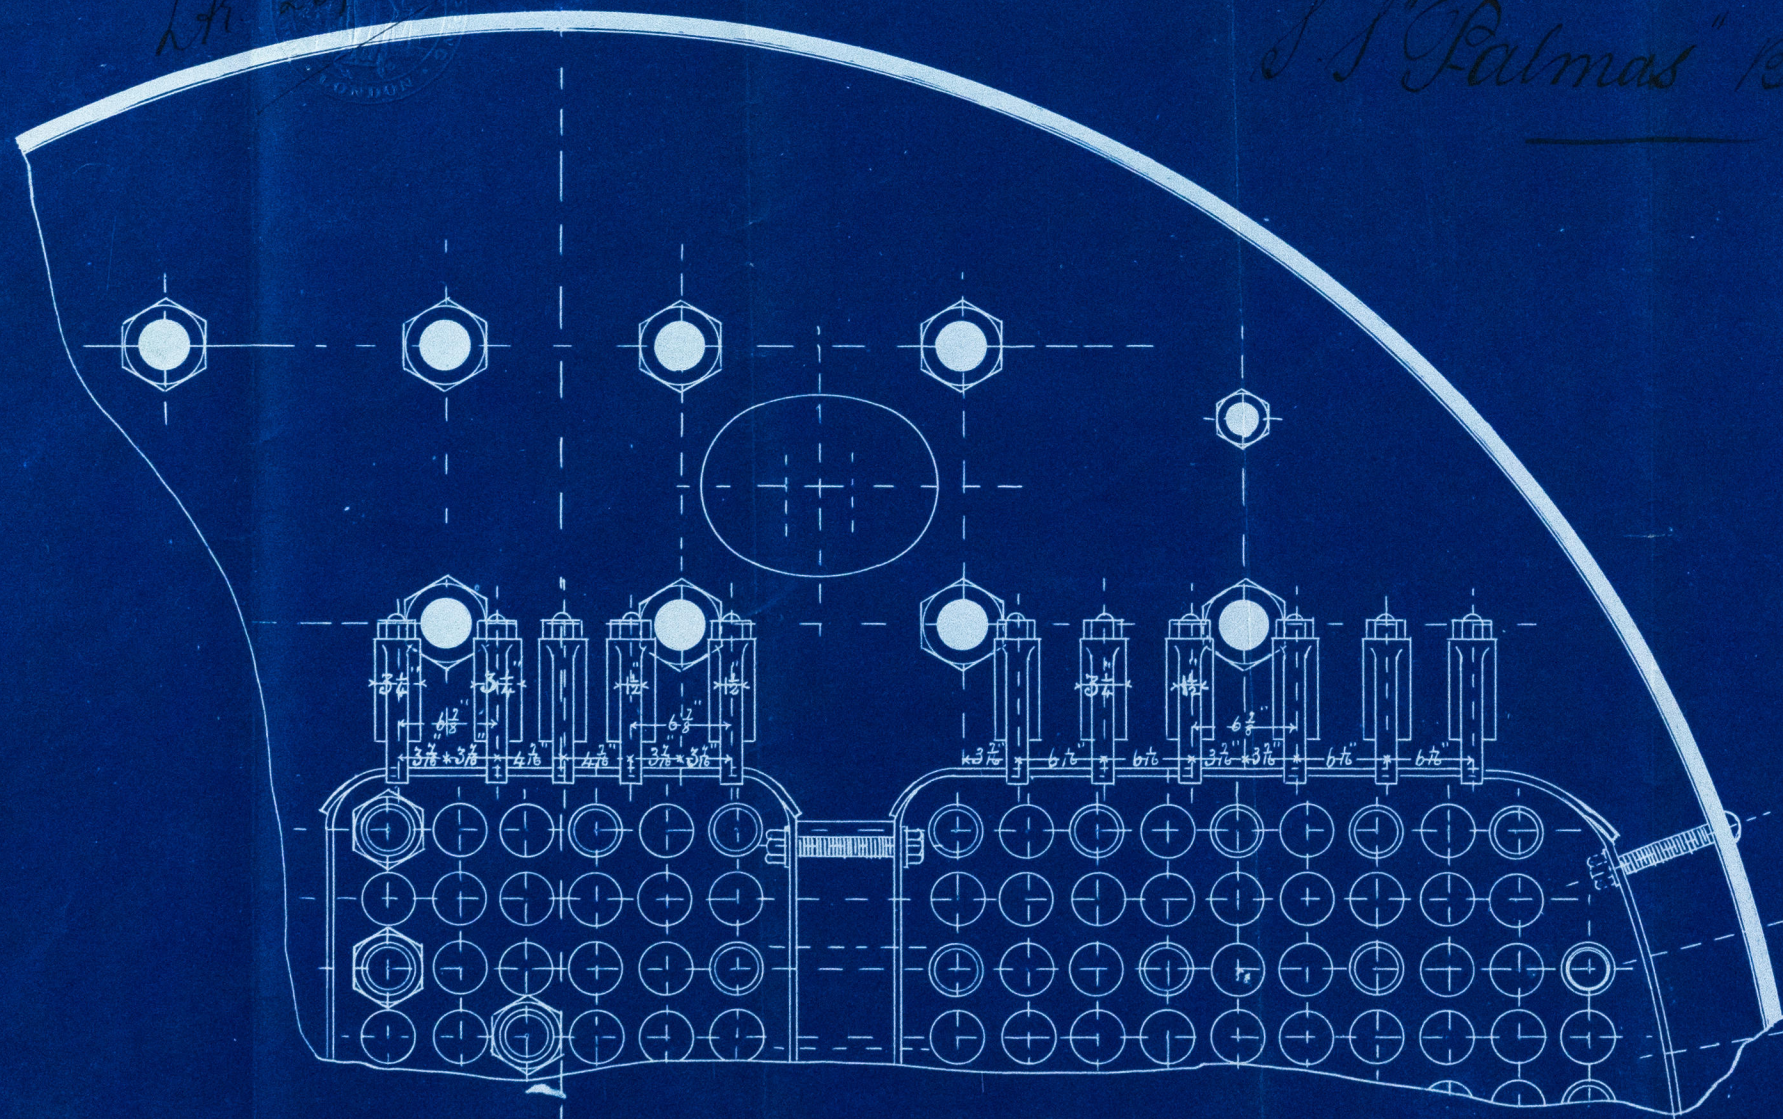

DP
24/4/88

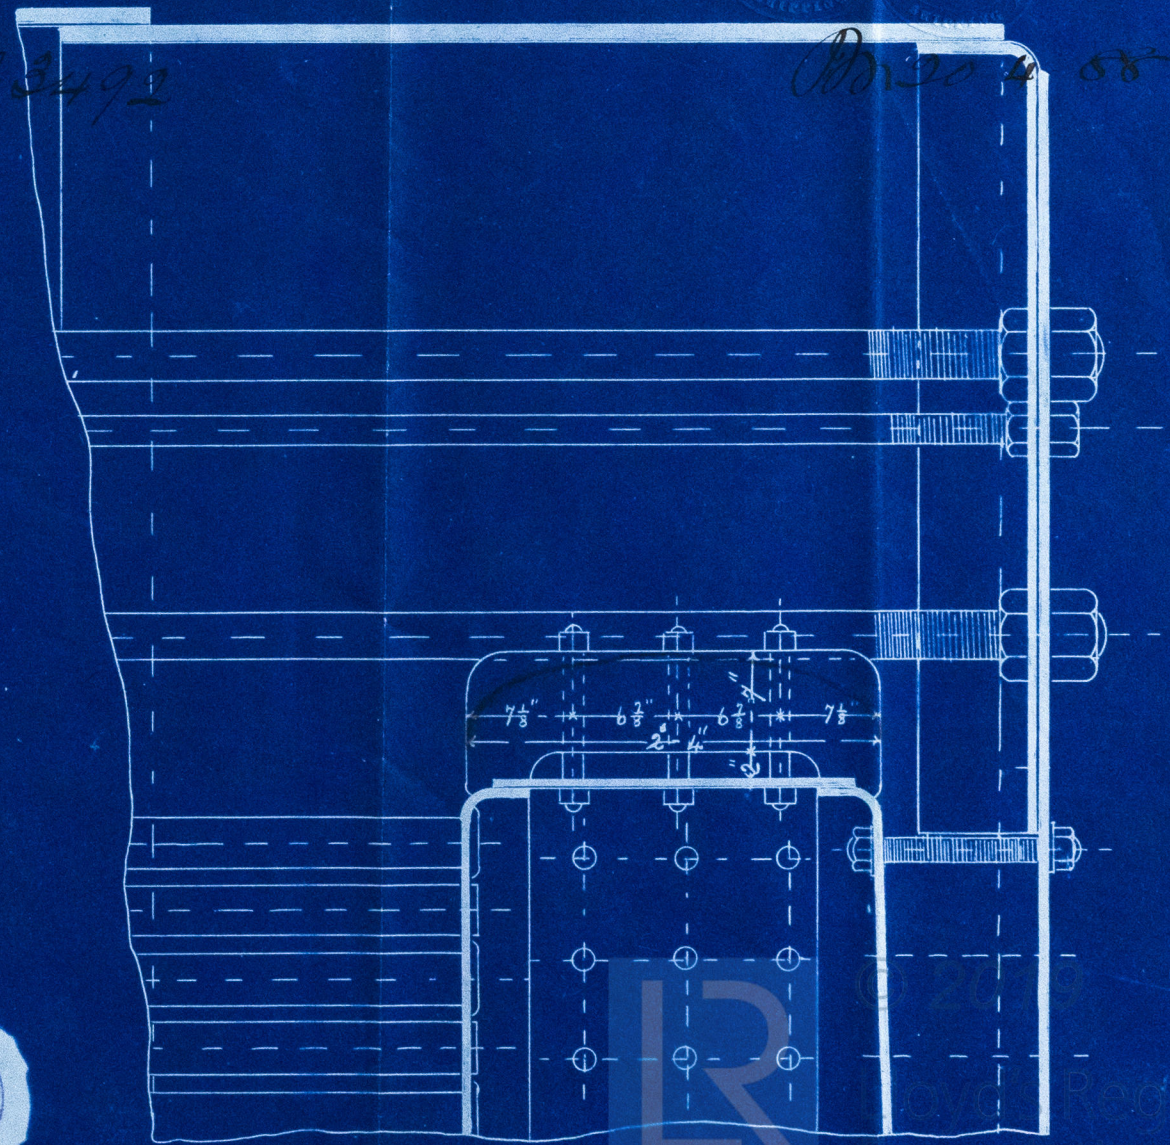

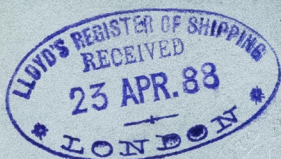

36655-0085



© 2019

Lloyd's Register
Foundation