

N^o 14. BK "Campbell" - Bel. Rep. 3576

N^o 10 "Cypria" Belfast Report N^o 3575

See list to
Bel. 24.5.88

Midship Section

Steel Barques N^{os} 10 & 11. 1874
Class 100 A1 at Lloyd's
Scale 1/2" = one foot.

N^o 11 Paul. Wenberg Belfast Report
N^o 3553

Raised 2" 2 1/2" less than 1/4 length of vessel.


N^o 13 County Antium Belfast Report
N^o 3560

Proportions
Breadth to length 5.97
Depth to length 8.94.

Dimensions
Length BP 218' 0"
Breadth 36' 3"
Depth 24' 2 1/2"
Depth of hold 22' 0"

1/2 birth 36.25
1/2 breadth 18.12
Depth 24.20
Frame 78.57 x 26.58 = 17016 + 75 = 18150 Equipt N^o 2

To connect beams - Butt 6" x 6" angles 6" x 6" x 1/2"

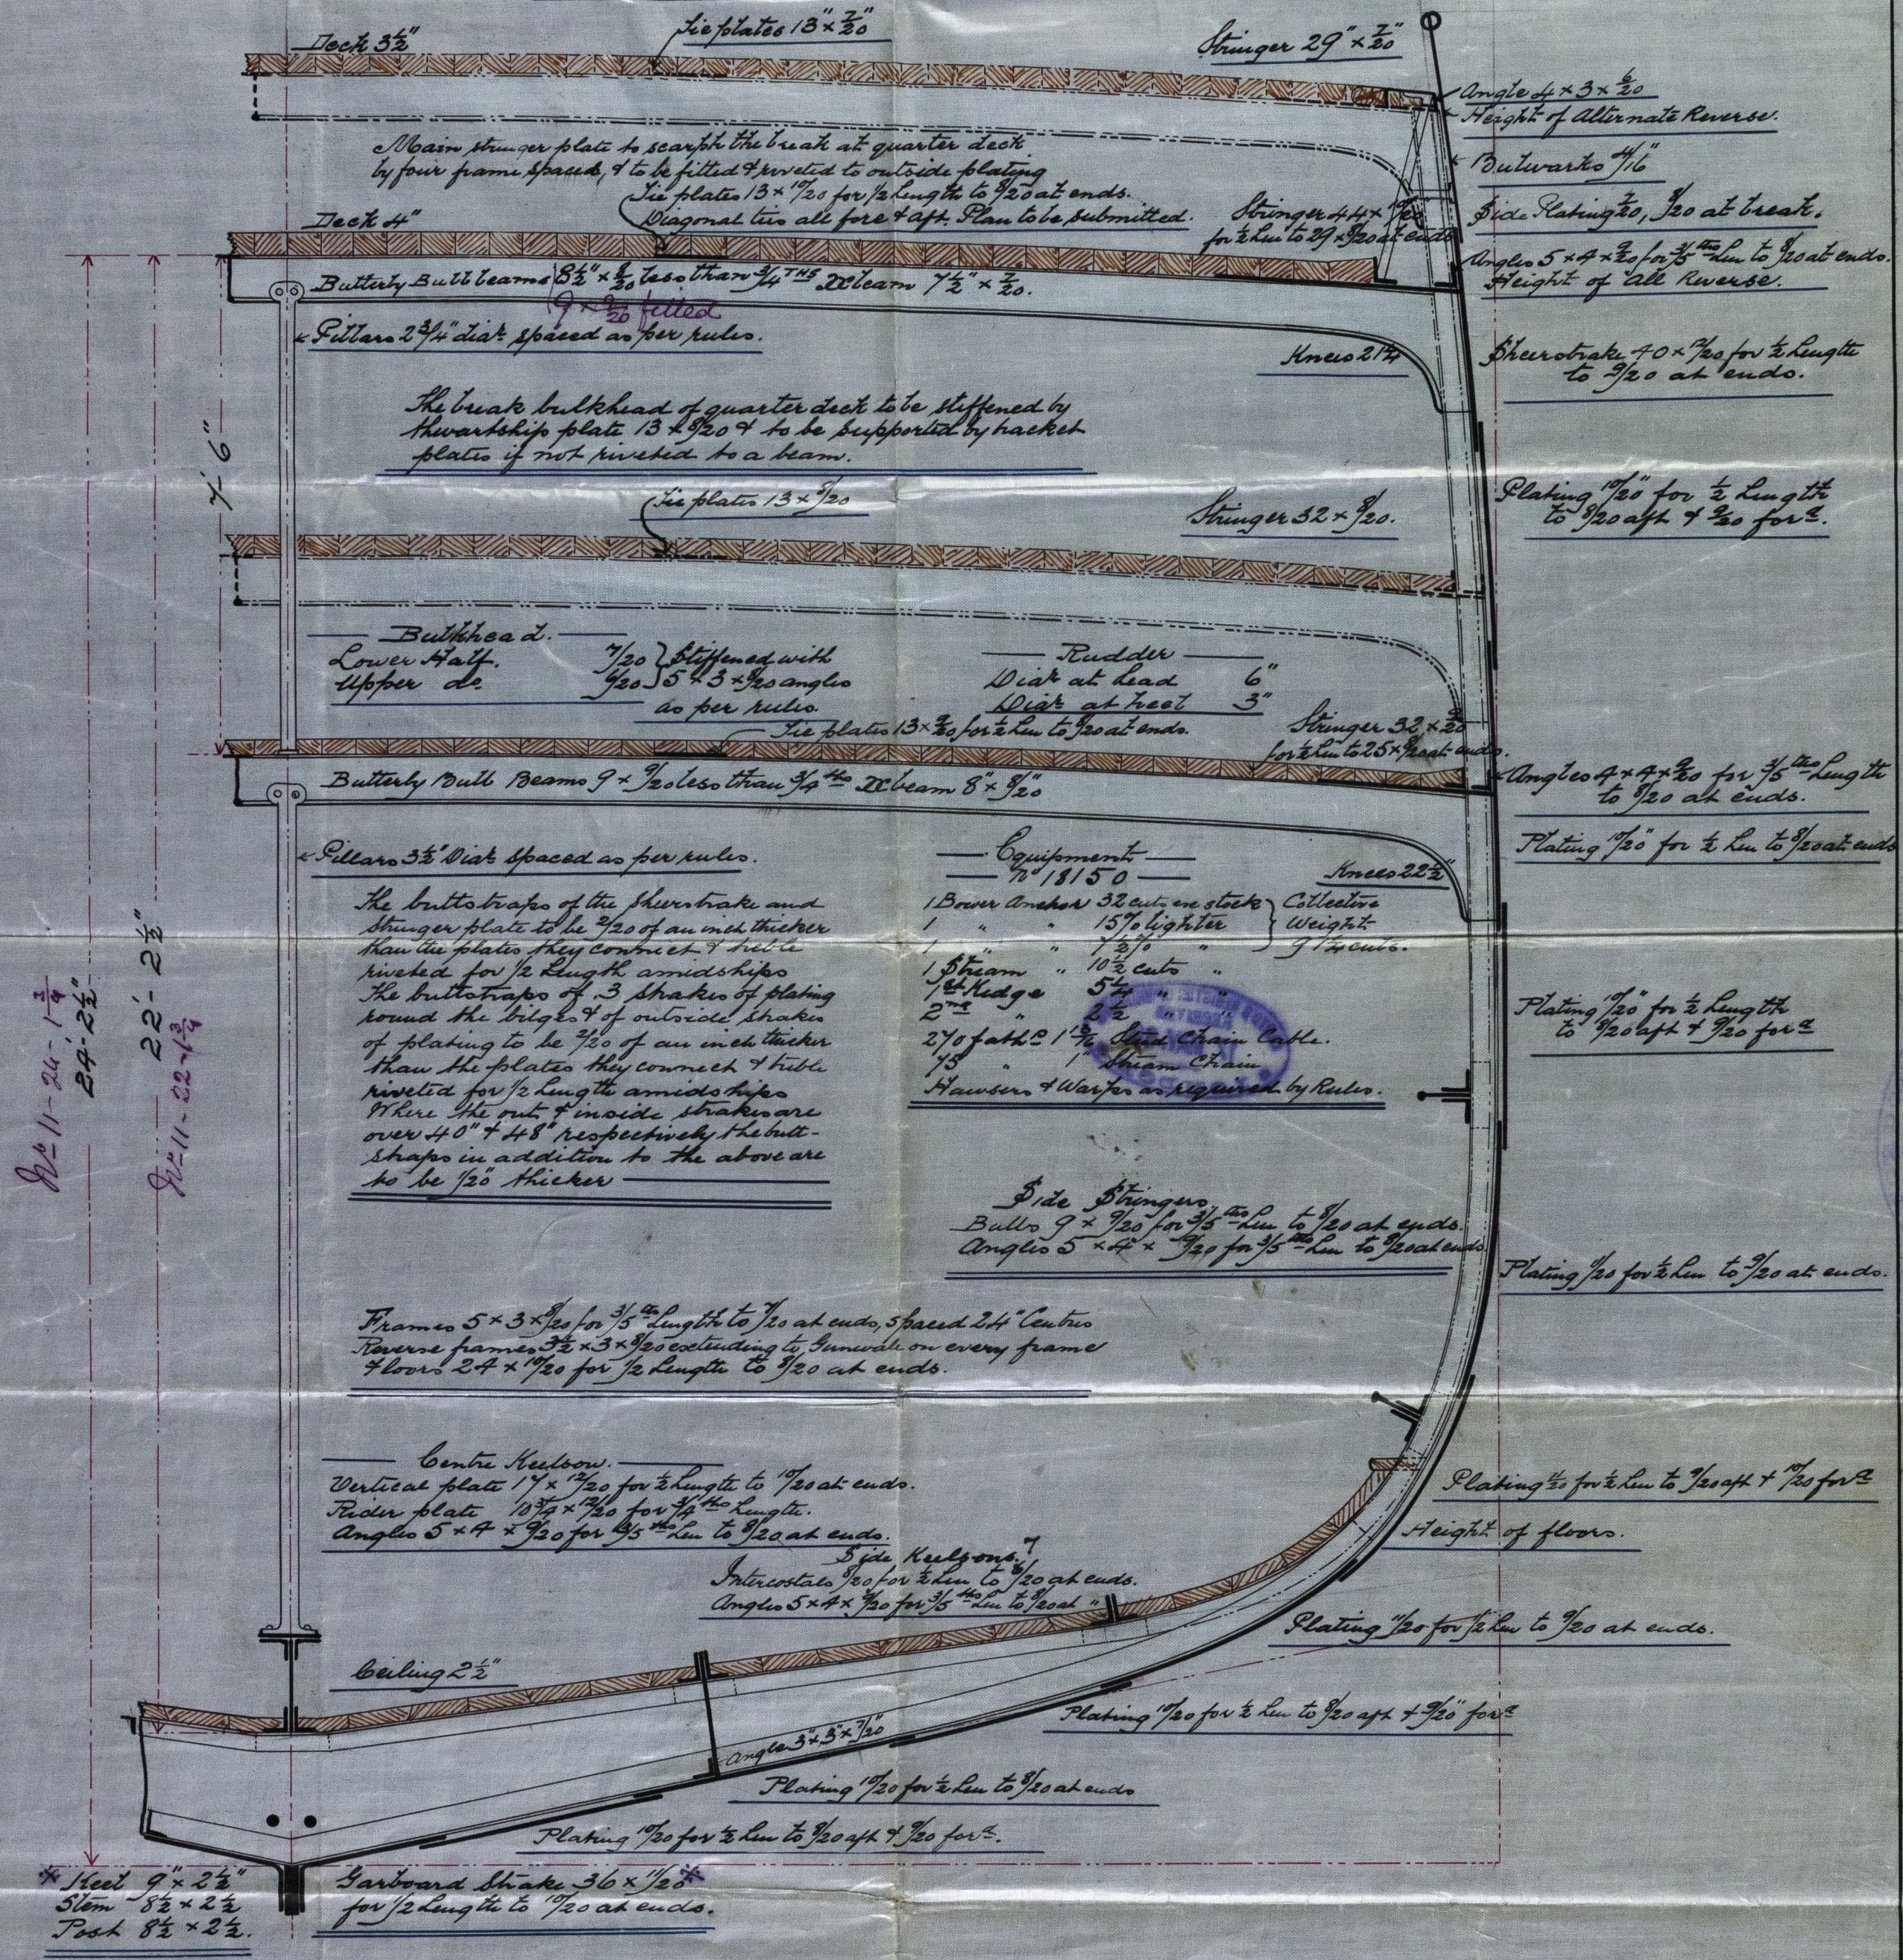

N^o 11-24-1 1/4
24-2 1/2
22-2 1/2
N^o 11-22-1 1/4

The butts of the struts and
struts plate to be 3/4" of an inch thicker
than the plates they connect & to be
riveted for 1/2 length of struts.
The butts of the 3 struts of plating
round the bulge of outside struts
of plating to be 3/4" of an inch thicker
than the plates they connect & to be
riveted for 1/2 length of struts.
Where the out & inside struts are
over 40" & 48" respectively the butts
of struts in addition to the above are
to be 3/4" thicker.

Equipment
N^o 18150
1 Bar Anker 33 cuts in stock
1 " 15% lighter
1 " 10% cut
1 " 5% cut
2 " 2% cut
2 1/2 fathoms 1 1/2" steel chain cable.
1 " 1 1/2" steel chain
Hawser & Warper as required by Rules.

Frames 5 x 3 1/2" for 1/5 length to 1/2 at ends, spaced 24" Centre
Reverse frames 3 1/2 x 3 1/2" extending to gunwale on every frame
Floors 24 x 1 1/2" for 1/2 length to 1/2 at ends.

Centre keelson.
Vertical plate 17 x 1 1/2" for 1/2 length to 1/2 at ends.
Rider plate 18 1/2 x 1 1/2" for 1/2 length to 1/2 at ends.
Angles 5 x 4 x 1 1/2" for 1/5 length to 1/2 at ends.

Side keelsons.
Interstate 1 1/2" for 1/2 length to 1/2 at ends.
Angles 5 x 4 x 1 1/2" for 1/5 length to 1/2 at ends.

* Keel 9 x 3 1/2"
Stern 8 1/2 x 2 1/2"
Post 8 1/2 x 2 1/2"

Garboard strake 36 x 1 1/2"
for 1/2 length to 1/2 at ends.

Forgings, Standions, Strips, Rivets, &c all as permitted by rules to be of Iron.

* Keels of N^{os} 10 & 11 - 8 1/2 x 2 1/2
Garboards - " - 12
20



1874
20/5/88
16.5.88





Plating 100 for 100 at once





Bel 55-0188



Lloyd's Register
Foundation