

The words FORGINGS or CASTINGS, IRON or STEEL, should be struck out as may be required.

Received at

Belfast

Office,

June 25th 1888

Lloyd's Register of British and Foreign Shipping.

(Report on Vessel No. 10

Port

Belfast)

No. 1446

SHIP FORGINGS OR CASTINGS.

I have to report that the undermentioned Iron or Steel Forgings or Castings, manufactured by

The Lancefield Forge Co. of Glasgow.

for the Vessel No. 10, being built by Mr C. J. Bigger.

of Londonderry.

have been inspected by me as set forth below, and found to be, so far as can be seen, sound and efficient.

Mark on Forgings.

Lloyd's

No. 1446

C.N.


George Newcomb.

Glasgow.

23/6/88.

	STERN FRAME.	RUDDER FRAME.	STEM.
Material* - - -	Scrap iron.		Scrap iron
How made - - -	Forged.		Forged
Dimensions - - -	8½ x 2½		8½ x 2½
Progress on Inspection	Forging & smithing.		Forging.
Dates when Inspected	2.5.12.14/6/88.		29/5/88. 2/6/88.

SKETCHES OF FRAMES SHEWING POSITION AND DESCRIPTION OF WELDS OF FORGINGS, OR PARTICULARS OF TESTS APPLIED TO CASTINGS.

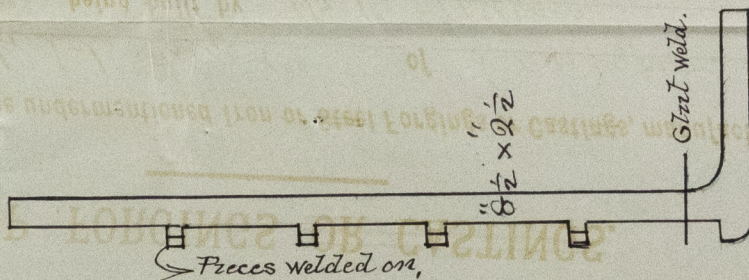

C. L. Bigger's No. 10.
Stem Post & Stem Logg

BK "Cupica"
Belfast Report
No. 3515



© 2019

Lloyd's Register
Foundation