

Received at Belfast Office Oct. 20th 1888

Lloyd's Register of British and Foreign Shipping.

(Report on Vessel No. 213 Port Belfast)

No. 1618

SHIP FORGINGS ~~OR CASTINGS.~~

I have to report that the undermentioned Iron ~~or Steel~~ Forgings ~~or Castings~~, manufactured by
The Lancefield Forge Co. of Glasgow.
for the Vessel No. 213, being built by Messrs Harland & Wolff.
of Belfast. have been inspected by me as set forth below, and found
to be, so far as can be seen, sound and efficient.

Mark on Forgings.

Lloyd's
No. 1618.
G.N.


George Newcomb.

Glasgow

18/10/88

	STERN FRAME.	RUDDER FRAME.	STEM.
Material* - - -		Scrap iron.	
How made - - -		Forged	
Dimensions - - -		$\frac{7}{8}$ dia.	
Progress on Inspection -		Forging & smithing	
Dates when Inspected		2.5.8/88. 4.20/88. 4.8.11. 13/10/88.	

SKETCHES OF FRAMES SHEWING POSITION AND DESCRIPTION OF WELDS OF FORGINGS, OR PARTICULARS OF TESTS APPLIED TO CASTINGS.

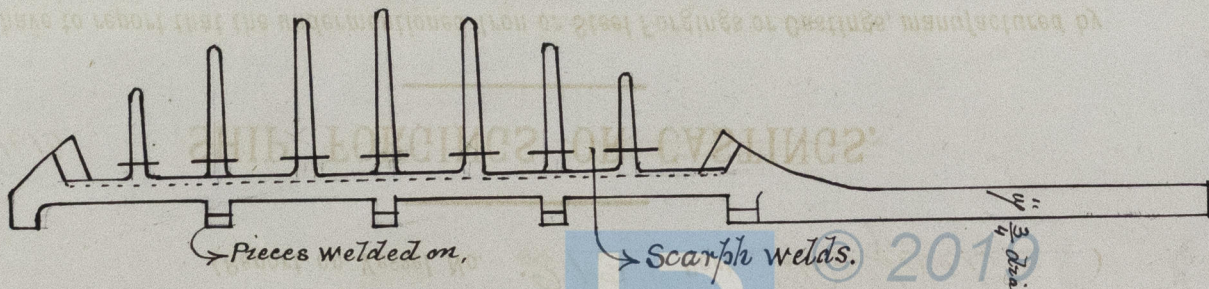

Harland & Wolff N^o 213.
Rudder Frame Forging

213 L. S. S.
Lord Londonderry }
Belfast Report
N^o 3516



© 2019

Lloyd's Register
Foundation