

Longitudinal Section N^o 58 S^s - Star of England - Bel. Fleebard Repts N^o 555
 Scale 1/8" = one foot - First Entry - - - 3543

Twist Entry - v - v 3543

12.1.88
3.3.88

Panting beams & shingles at
ends of the vessels to the Surveyors
satisfaction.

18m
12/1/88



 2019
 Lloyd's Register
 Foundation



REL53-0267








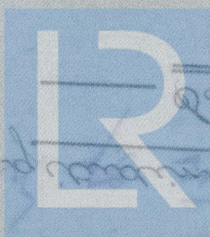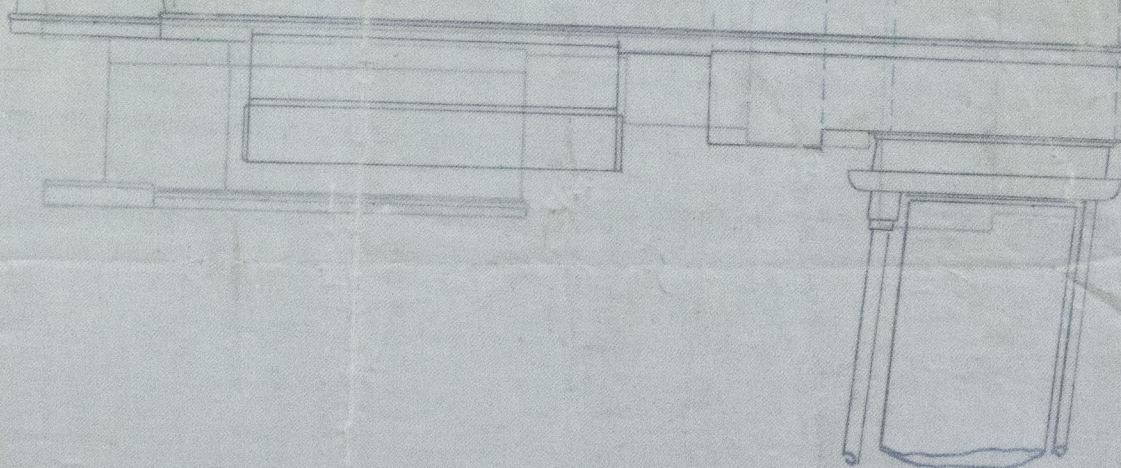

© 2019

Lloyd's Register
Foundation