

Received at Belfast Office, 24 Sept 1888.

Lloyd's Register of British and Foreign Shipping.

(Report on Vessel No. 12 Port Belfast)

No. 1459. SHIP FORGINGS ~~OR CASTINGS~~.

I have to report that the undermentioned Iron ~~or Steel~~ Forgings ~~or Castings~~, manufactured by The Portlanel Forge Co. of Kilmarnock, for the Vessel No. 12, being built by Mr Charles J. Bigger of Londonderry, have been inspected by me as set forth below, and found to be, so far as can be seen, sound & efficient.

The words FORGINGS or CASTINGS, IRON or STEEL, should be struck out as may be required.

Mark on Forgings.


Lloyd's
No. 1459
G. N.

George Newcomb
Glasgow

21/9/88.

	STERN FRAME.	RUDDER FRAME.	STEM.
Material* - - - -	<u>Scrap iron.</u>		
How made - - - -	<u>Forged</u>		
Dimensions - - - -	<u>9 x 5 1/2</u>		
Progress on Inspection -	<u>Forging & smithing</u>		
Dates when Inspected	<u>3.6.10/11/88. 8.14.23.31/8/88</u> <u>4/9/88.</u>		

SKETCHES OF FRAMES SHEWING POSITION AND DESCRIPTION OF WELDS OF FORGINGS, OR PARTICULARS OF TESTS APPLIED TO CASTINGS.

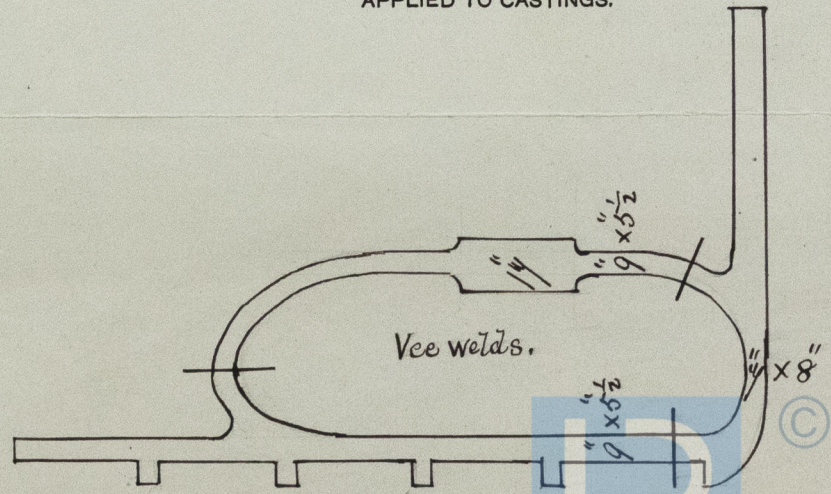

* If of Iron, state whether scrap or puddled Iron.

C. F. Rigger's M.
Star Frame Weighings

S. S. Brandenburg
Belfast Report
No 3546



© 2019

Lloyd's Register
Foundation