

The words FORGINGS or CASTINGS, IRON or STEEL, should be struck out as may be required.

Received at *Belfast* Office, *April 6th 1889*

Lloyd's Register of British and Foreign Shipping.

(Report on Vessel No. *35* Port *Belfast*)

No. *157* SHIP FORGINGS ~~OR CASTINGS~~.

I have to report that the undermentioned Iron ~~or Steel~~ Forgings ~~or Castings~~, manufactured by *The Murray Forge Co* of *Liverpool* for the Vessel No. *35*, being built by *Mac Ilwaine, Lewis & Co. Ltd* of *Belfast*— have been inspected by me as set forth below, and found to be, so far as can be seen, *a good forging*.


Mark on Forgings.

Lloyd's
No. *L. 190*.
G.A.M.

Geo. A. Milner
Liverpool

	STERN FRAME.	RUDDER FRAME.	STEM.
Material* - - -	<i>Scrap Iron</i>		
How made - - -	<i>Forged</i>		
Dimensions - - -	<i>10 x 6"</i>		
Progress on Inspection -	<i>Forging</i>		
Dates when Inspected	{ <i>Dec 6-14 Feb 16-26th</i>		

SKETCHES OF FRAMES SHEWING POSITION AND DESCRIPTION OF WELDS OF FORGINGS, OR PARTICULARS OF TESTS APPLIED TO CASTINGS.

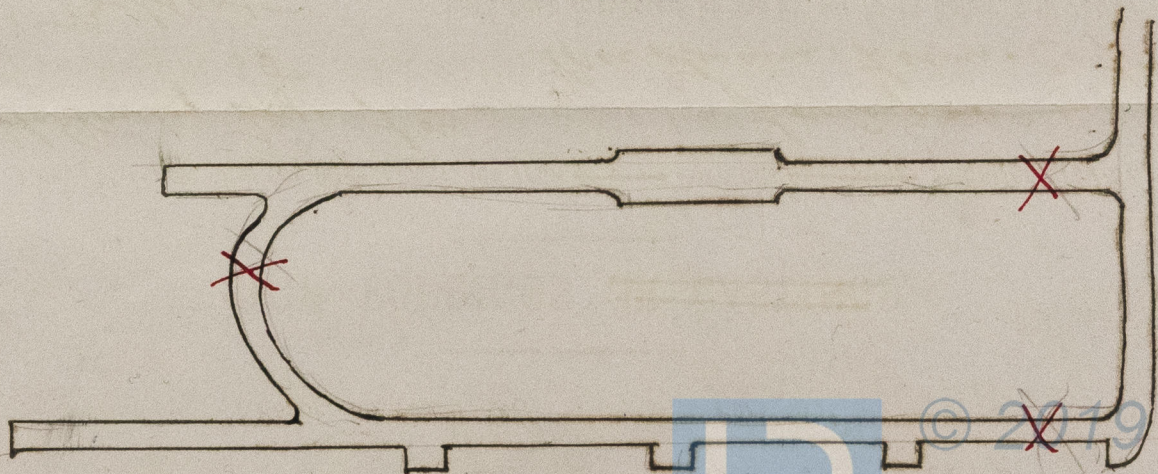

To be sent Belfast

✓ Welds

M^e Duane's No 25
Stirn Frame Forgings
April 6th 89

S.S. Mount Lebanon
Belfast Report
No 3630



© 2019

Lloyd's Register
Foundation