

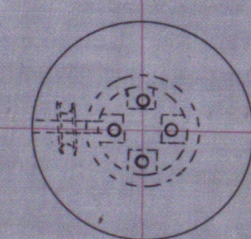
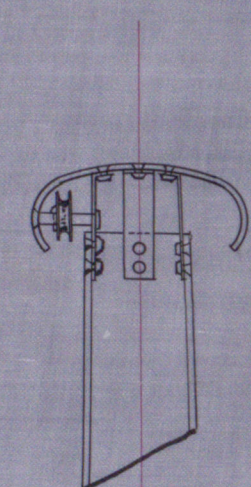


S. L. Mount Nelson
Belfast Report
No 3630

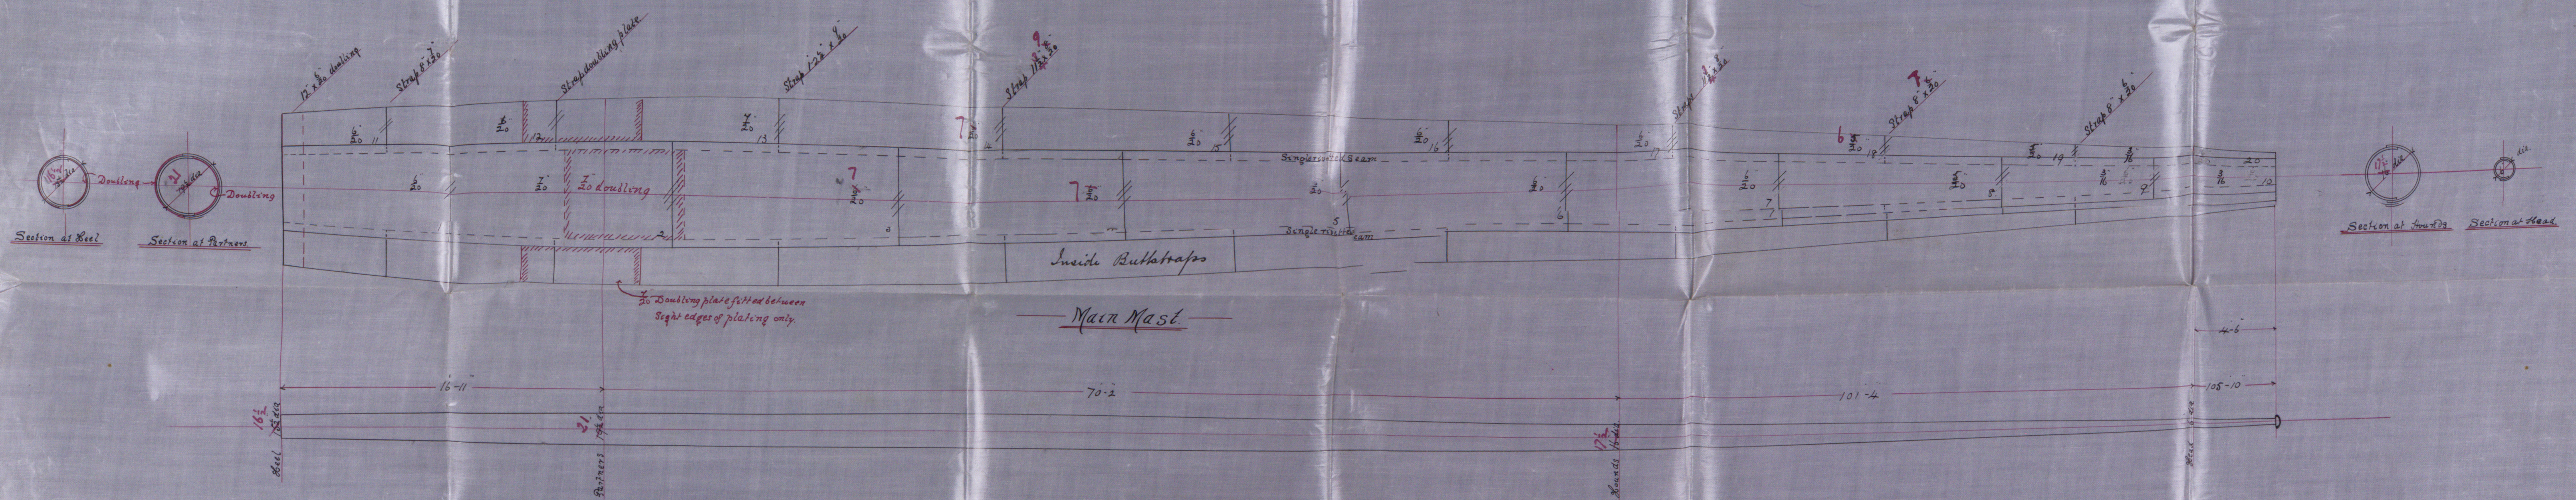


© 2019

Lloyd's Register
Foundation

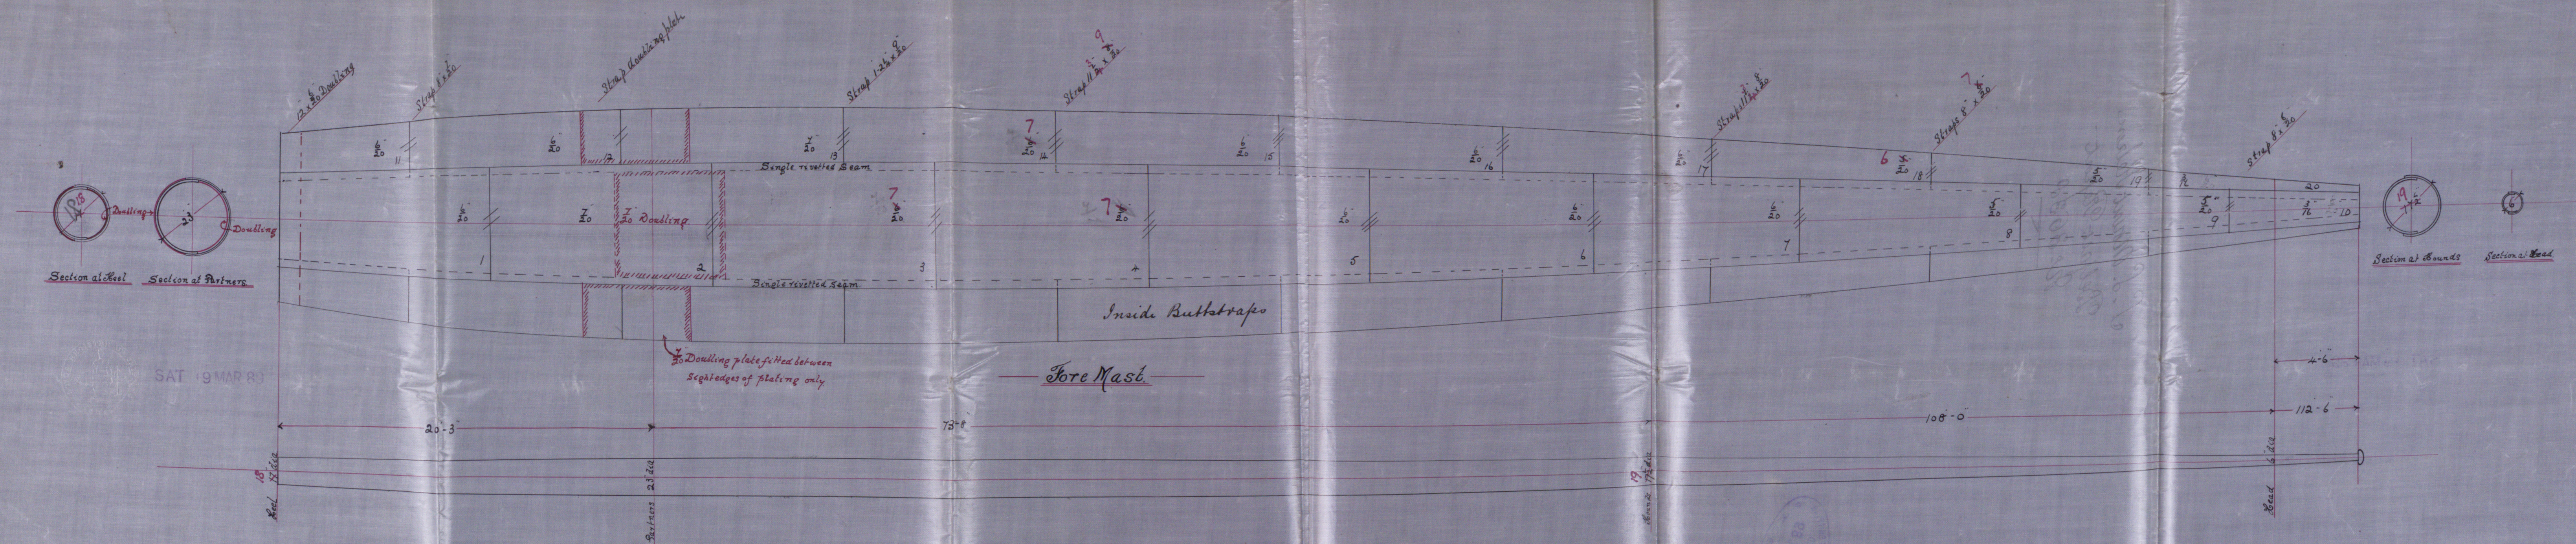

Detail of Trunk
Scale 1/2" = 1'

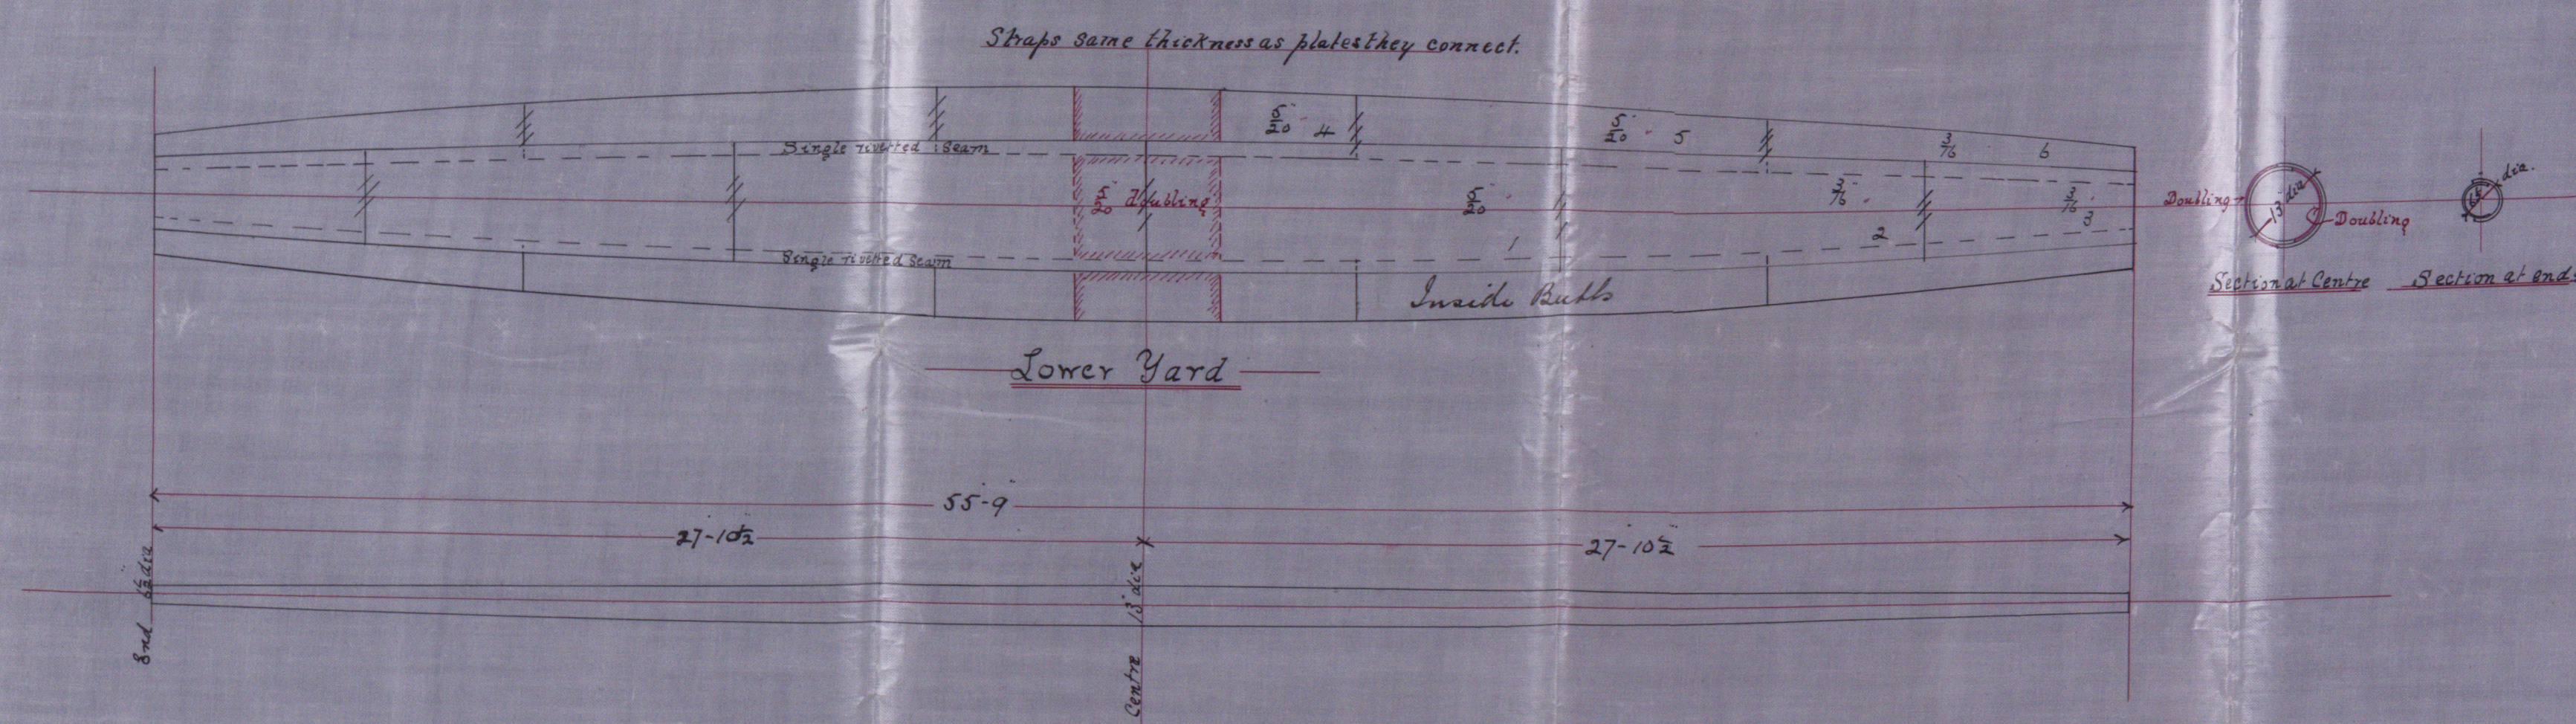

— No 35 —
MASTS & YARD

SCALE 1/2" = 1' OF AN INCH TO THE FOOT.

MAGILLWANE & MAGILL
LIMITED
No 760. 4-3-89
SHIP BUILDERS & ENGINEERS
BELFAST

for
J.S.S. 89