

(607) 19 mg bnd
(608) 20 mg bnd

(609) 1st - 2nd

20th May 1900

1872 11/15 246700

Dr. 4042


Lloyd's Register
Foundation

Dec 13/6/89



S.S. No 35.
Pumping Plan.
Scale 1/8" = 1 foot.

MAGILWAINE & MAGGILL,
LIMITED.
11-9/18. 18-5-89
SHIP BUILDERS AND ENGINEERS
BELFAST.

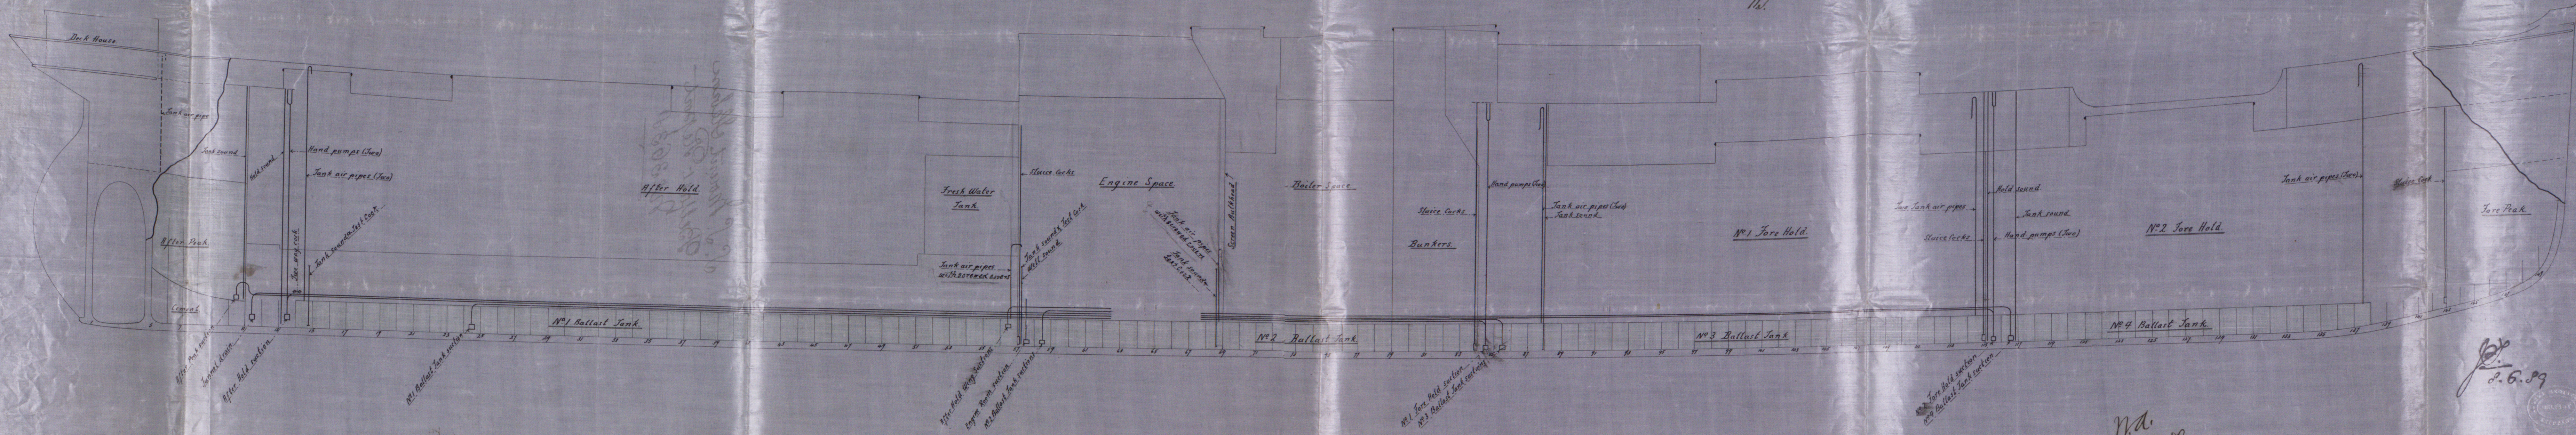

2.6.89

N.A.
11.6.89