

LLLOYD'S REGISTER OF SHIPING
RECEIVED
11 JUN. 89
LONDON

Mount Lebanon
Belpas Repas No 3634 &
No 3630

Mount Lebanon
Belpas Repas No 3634 &
No 3630

LLLOYD'S REGISTER OF SHIPING
RECEIVED
20 NOV. 89
LONDON


LLLOYD'S REGISTER OF SHIPING
RECEIVED
14 OCT. 88
LONDON



© 2019

Lloyd's Register
Foundation

S. L. Mount Lebanon
Belfast Report No. 3634
a Fleetland
First Entry Report No. 3630

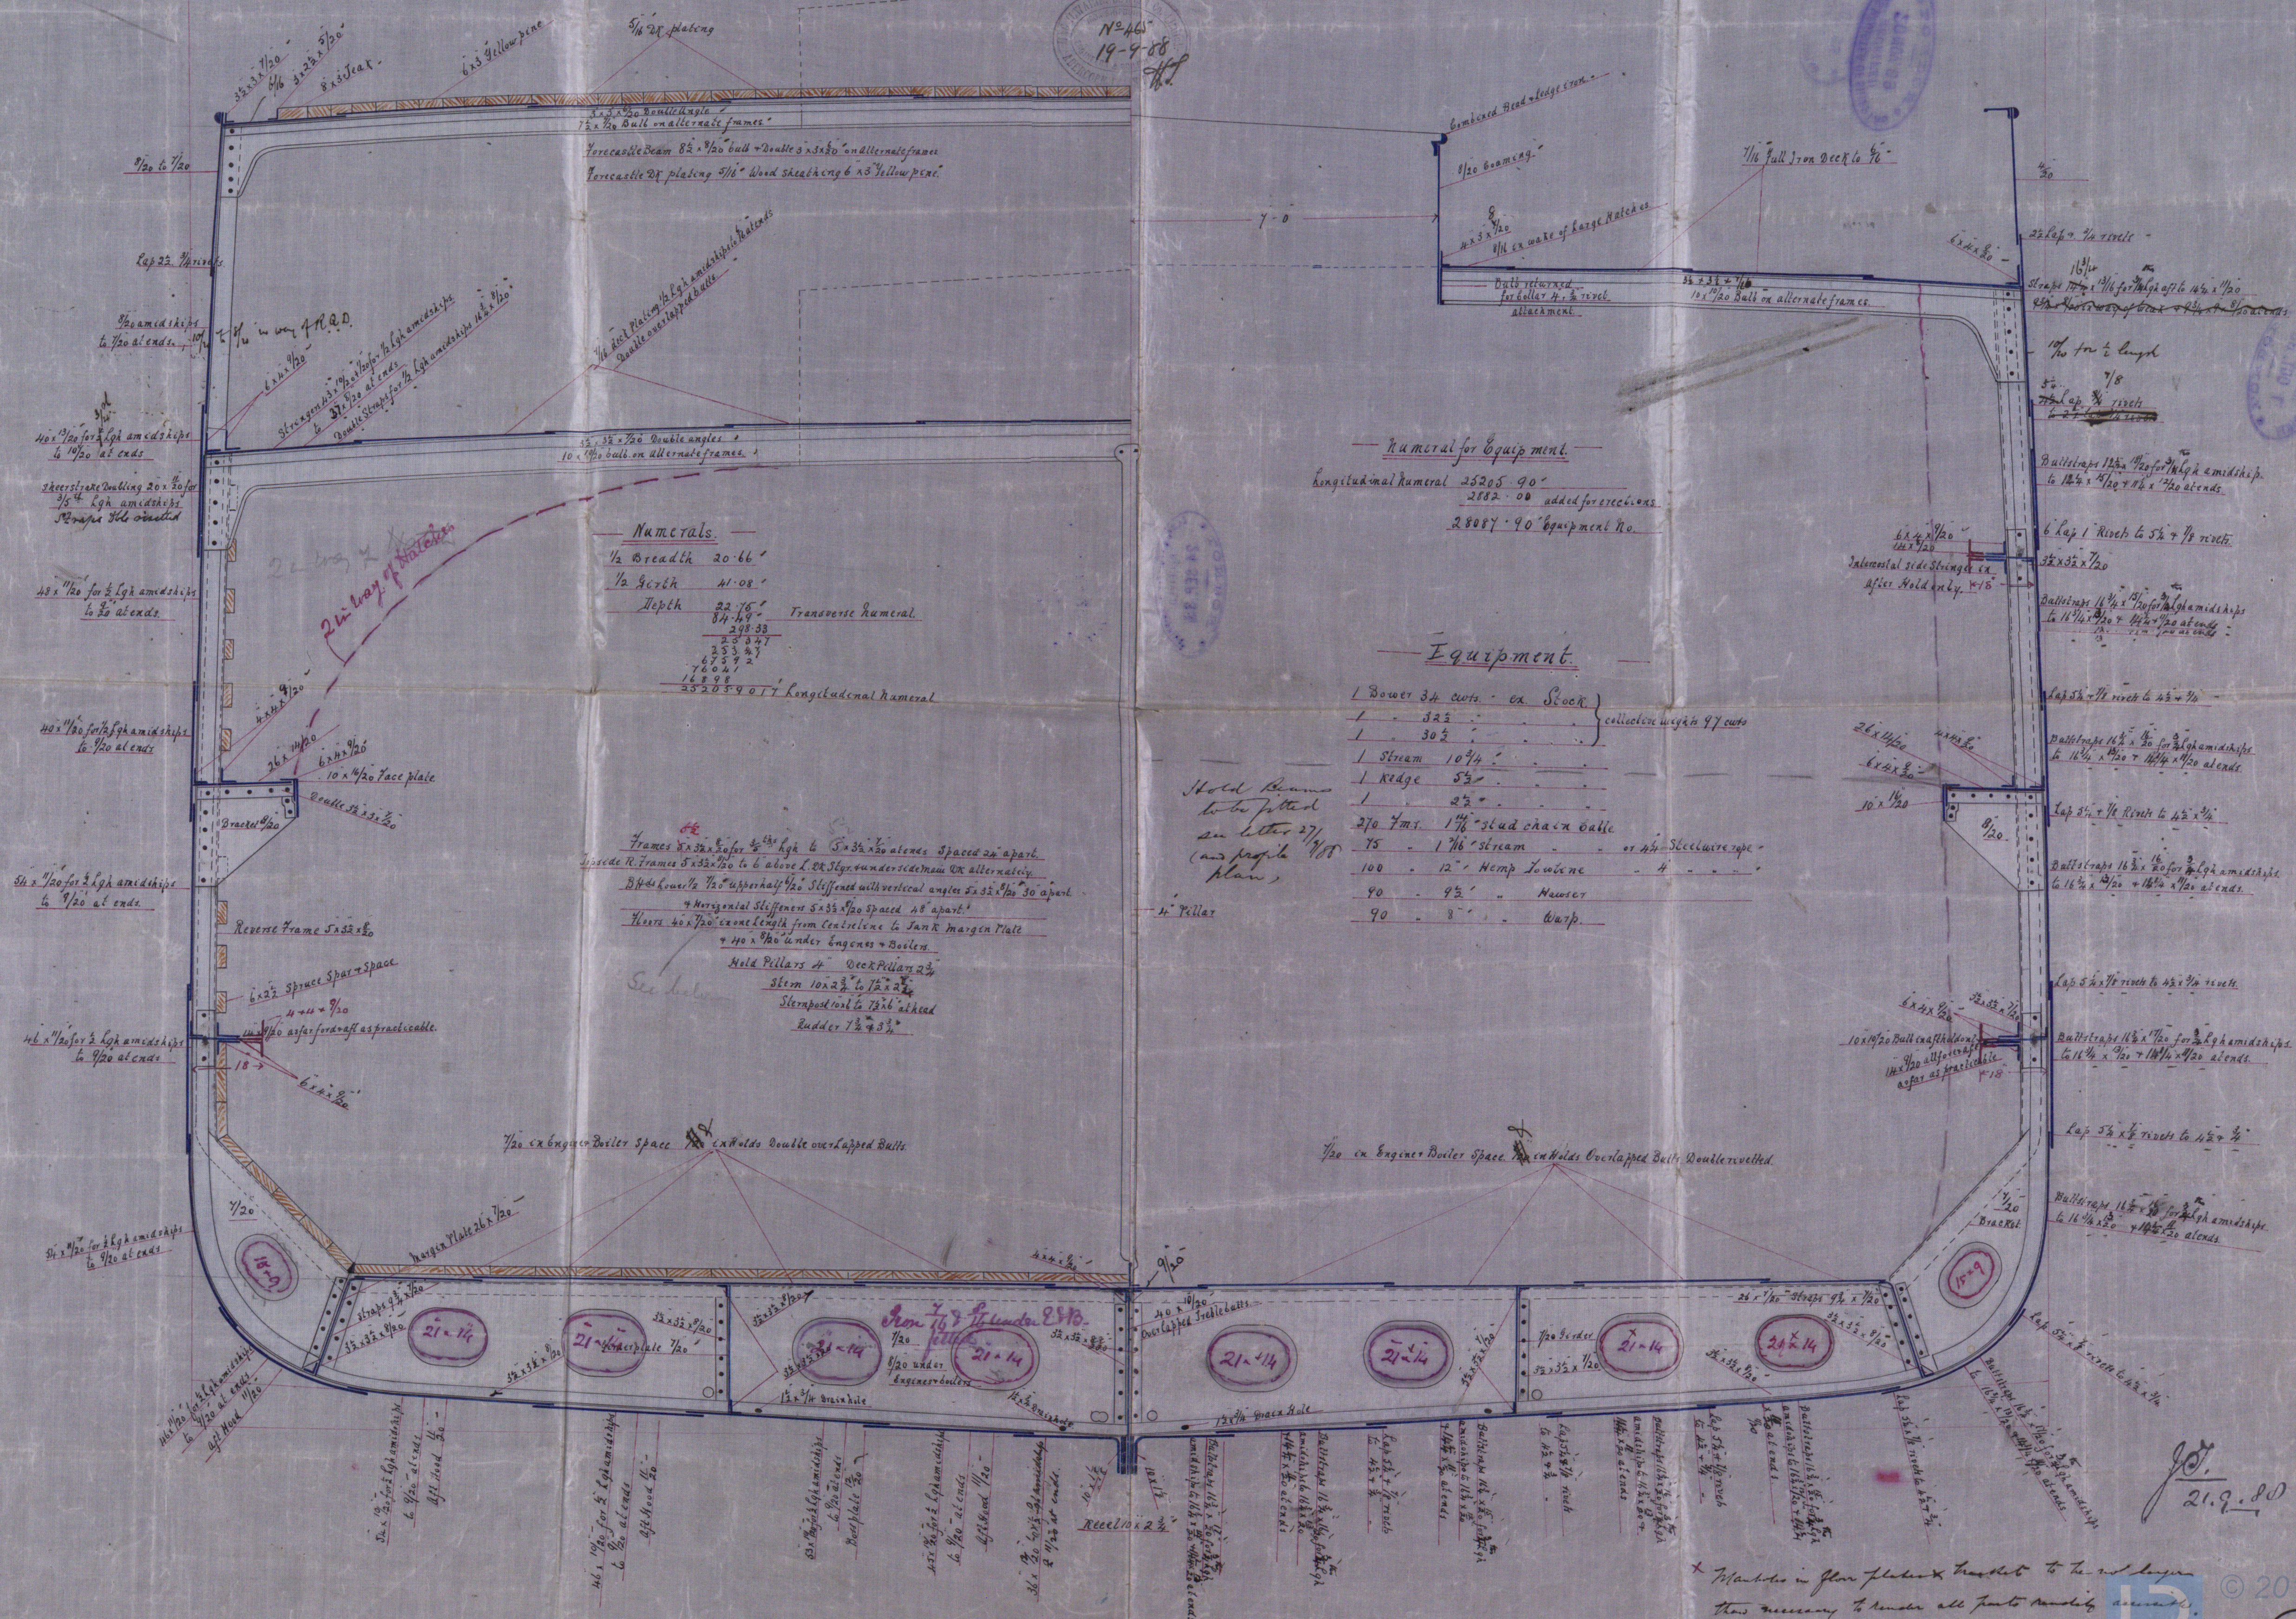

x Manholes in floor plates x tracklets to be not longer
then necessary to render all parts readily accessible