



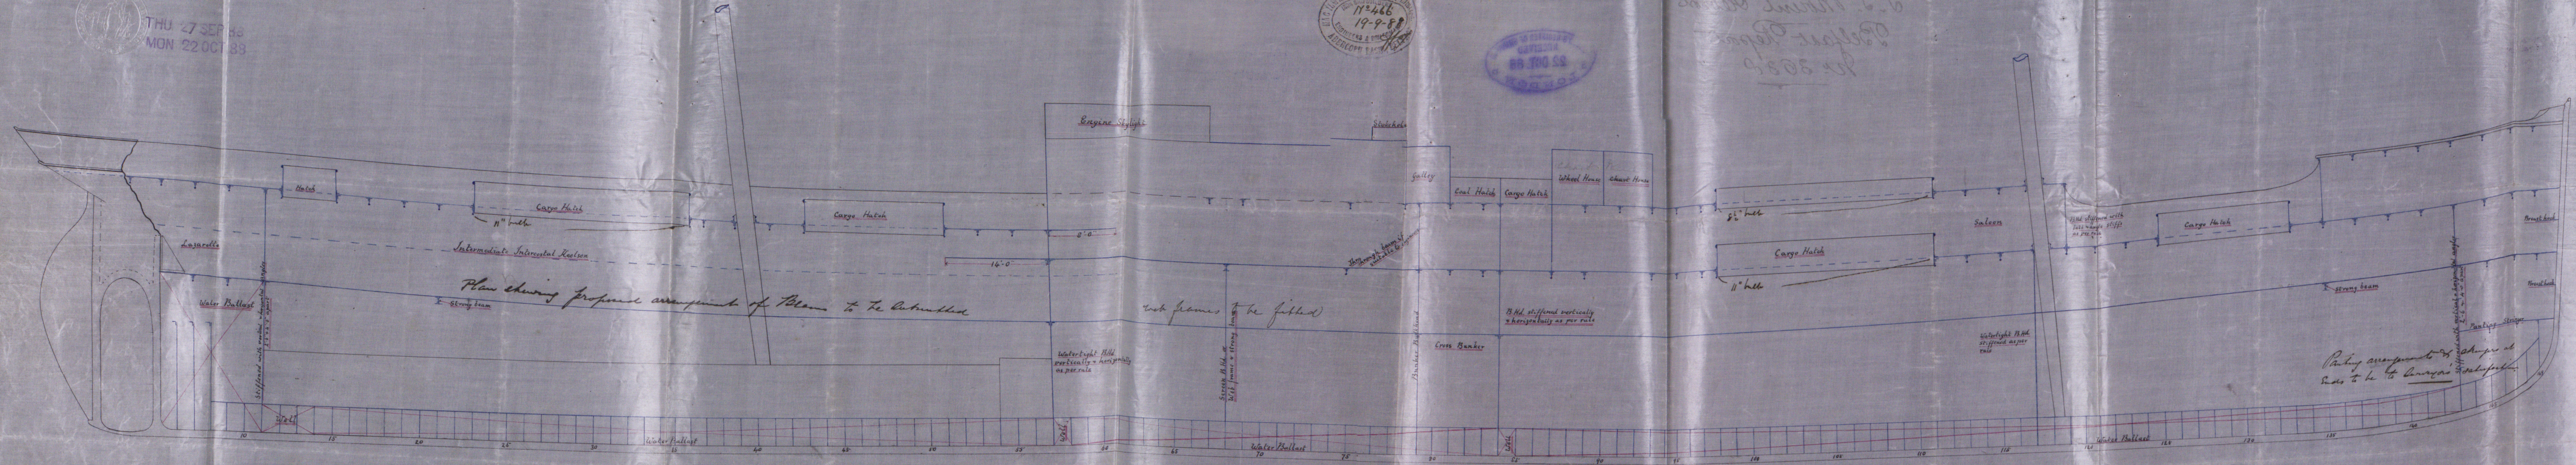

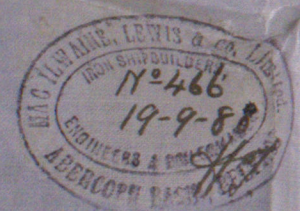

THU 27 SEP 88  
MON 22 OCT 88



Ends to be to Carriers satisfaction.

S.S. No 35  
Scale  $\frac{1}{8}'' = 1 \text{ ft.}$

21.9.200

Lloyd's Register  
5456-0127  
Foundation