


See also Report No. 3634
Mount Lebanon
Belfast Report

Mount Lebanon
Belfast Report
No. 3634

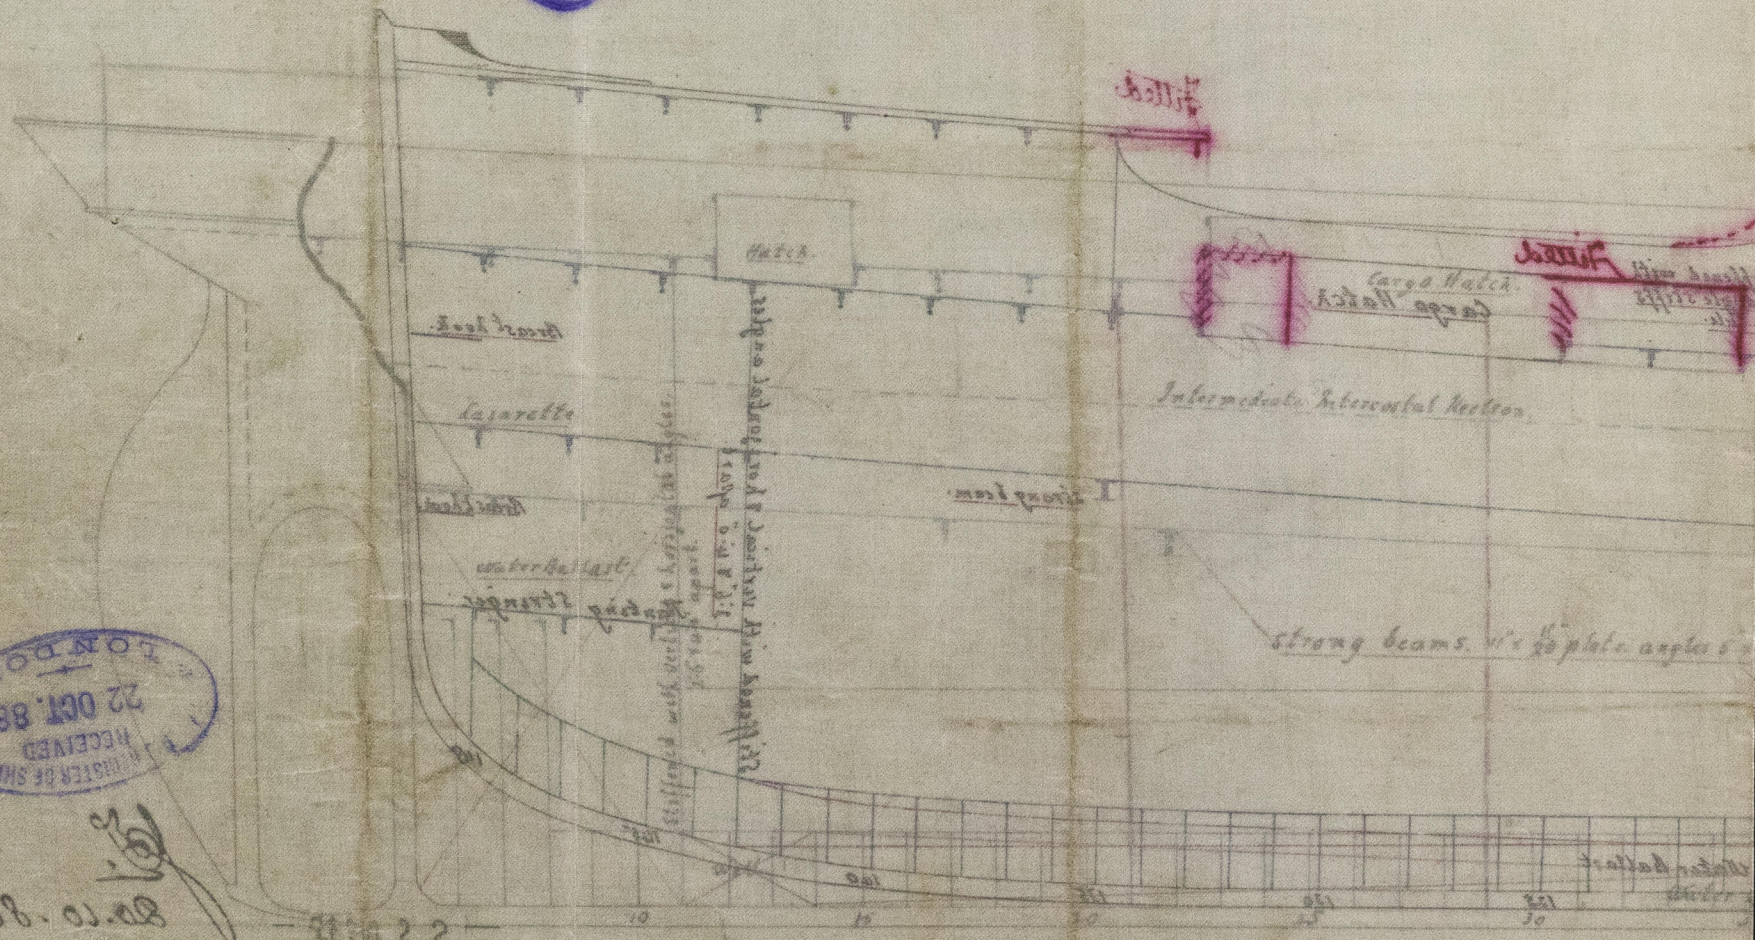

80.10.80

2007-1-1000



8822-0758



© 2019
 Lloyd's Register
 Foundation

Seels to Bel.
MON 22 OCT 33

L. P. Mount Lebanon
Belfast Freeboard Report No. 3634

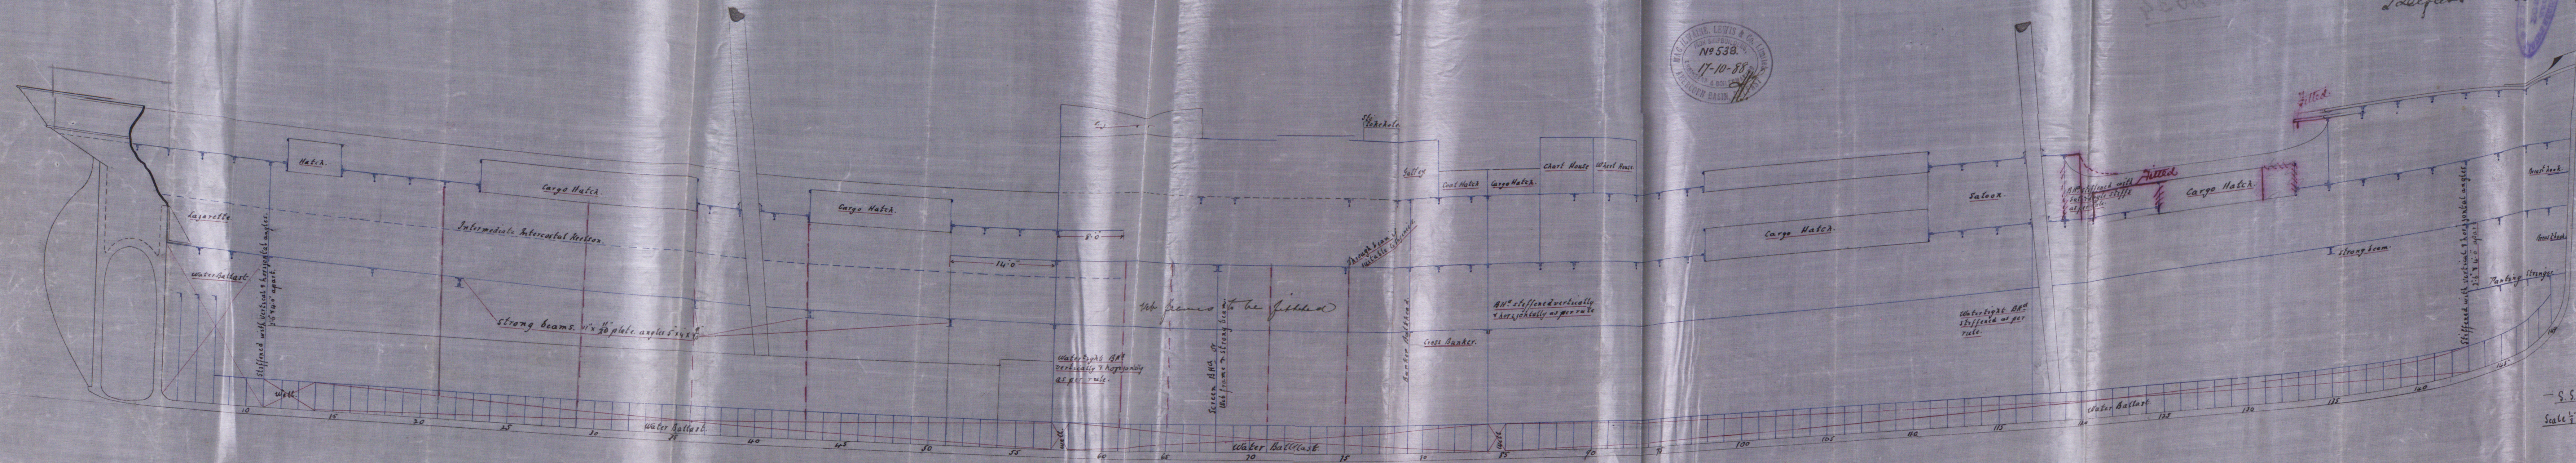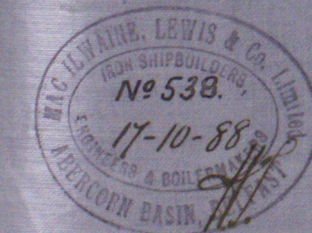

— S. S. N^o 35 —

Scale $\frac{1}{2}'' = 1 \text{ foot}$

20.10.800