


S.S. "County Down"
Belfast L.R. No. 3652
10/1/90

First Entry No. 3678

Chichester

Ref. No. 3691


web frames etc
strong bedsteads
engines furniture Boilers

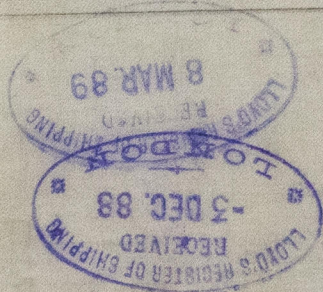

© 2019

Lloyd's Register
Foundation

— Longitudinal Section N° 66 S/S Comparison. Fig. 65. Thickets
— Scale 1/2 inch = one foot. —

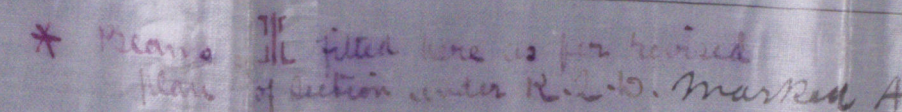

Pm. 12.11.88

18M
15/11/88

4/12/88