


S. S. "County Down" Belfast Report No 3648.
" " " " 3691

12
1
12

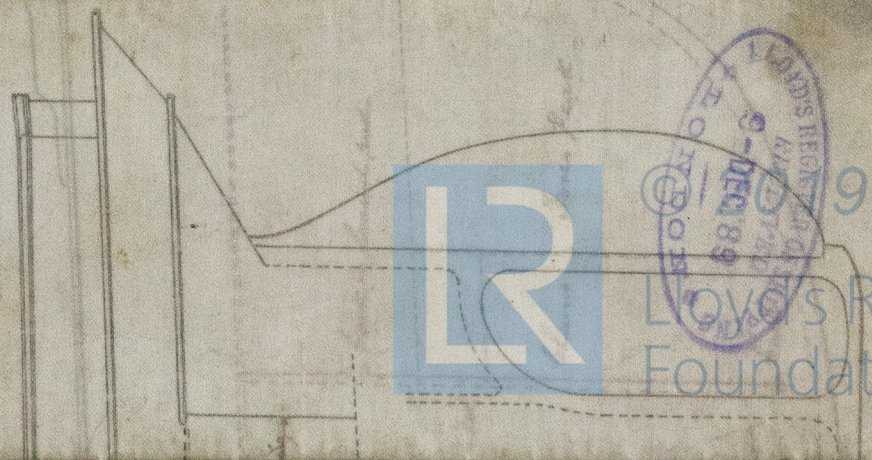


Lloyd's Register
Foundation

Sta: 10: 12: 89

Pumping Arrangement Nos 66 & 68 S.S.

County Town N^o 66
Chechester N^o 68

Scale $\frac{1}{8}$ inch = 1 ft.

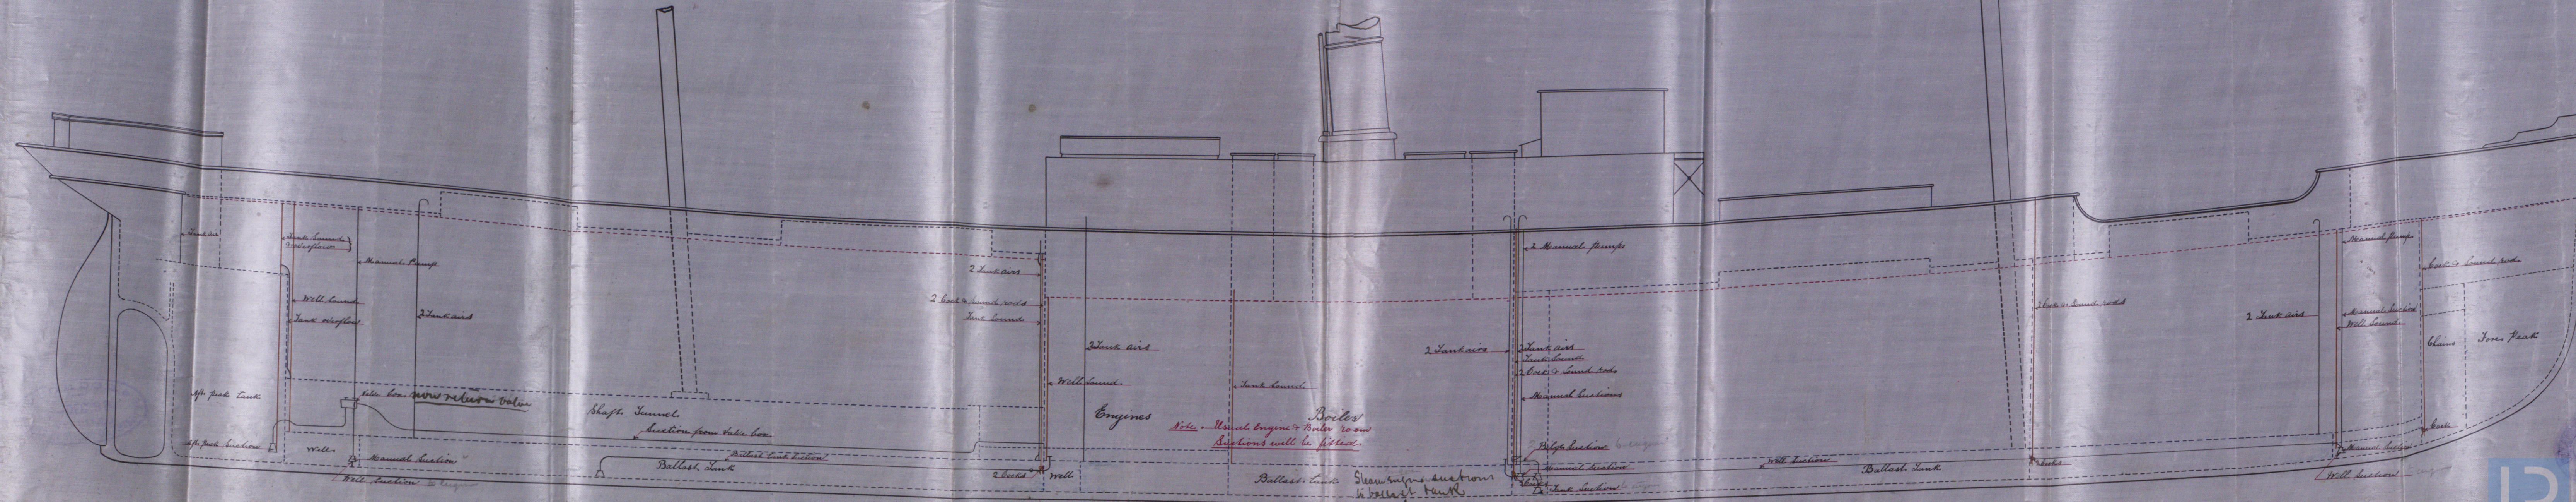

Ad
9.12.8



BEL56-0200

FROM