


A

Revised plan.


Section in way of Raised Quarter Deck No 66 S.S. *County Down*
Richester

TUE 27 NOV 88
TUE 14 DEC 88

Scale 1/2 inch = one foot.

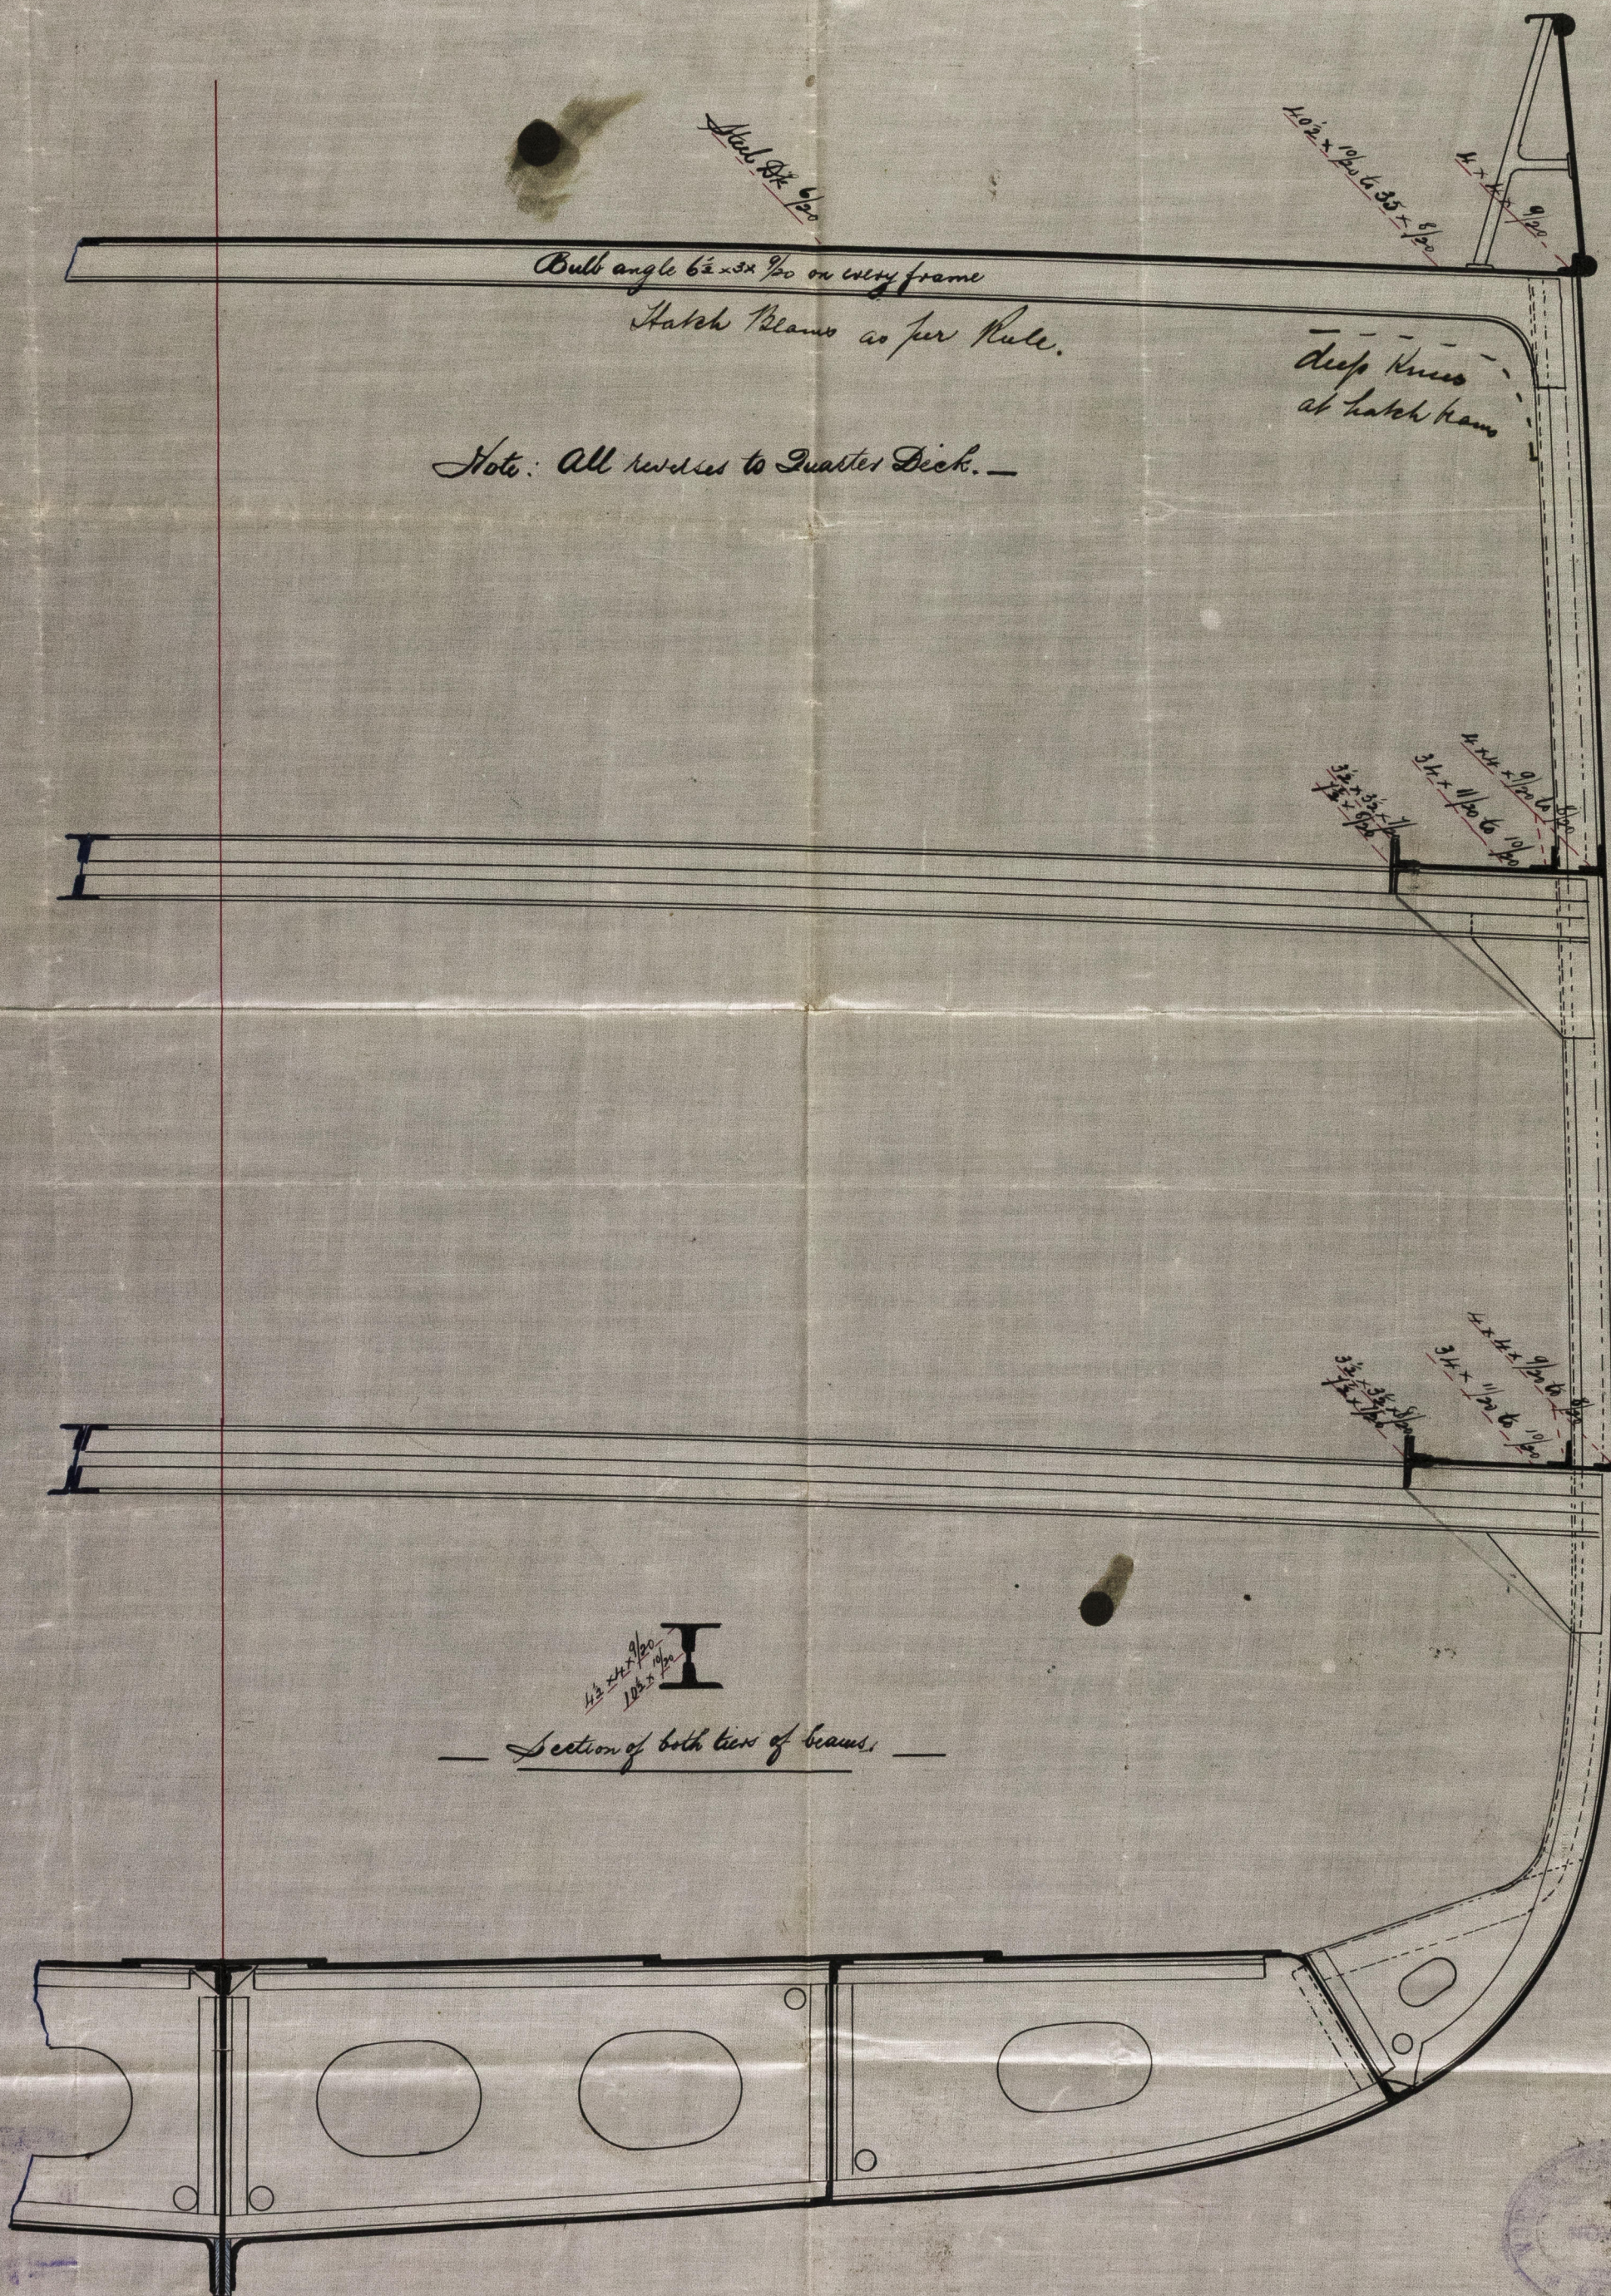

M. 25.11.88

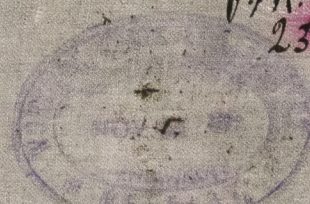

© 2019

Lloyd's Register Foundation

B6456-0213

S.S. County Down

Bel. ¹²¹ Rept N^o 3578

S.S. Chichester

Bel. Rept N^o 3691

121

121



© 2019

Lloyd's Register
Foundation