



S.S. "County Down" Belfast 4. 12. 1901 3652. 90-1-90

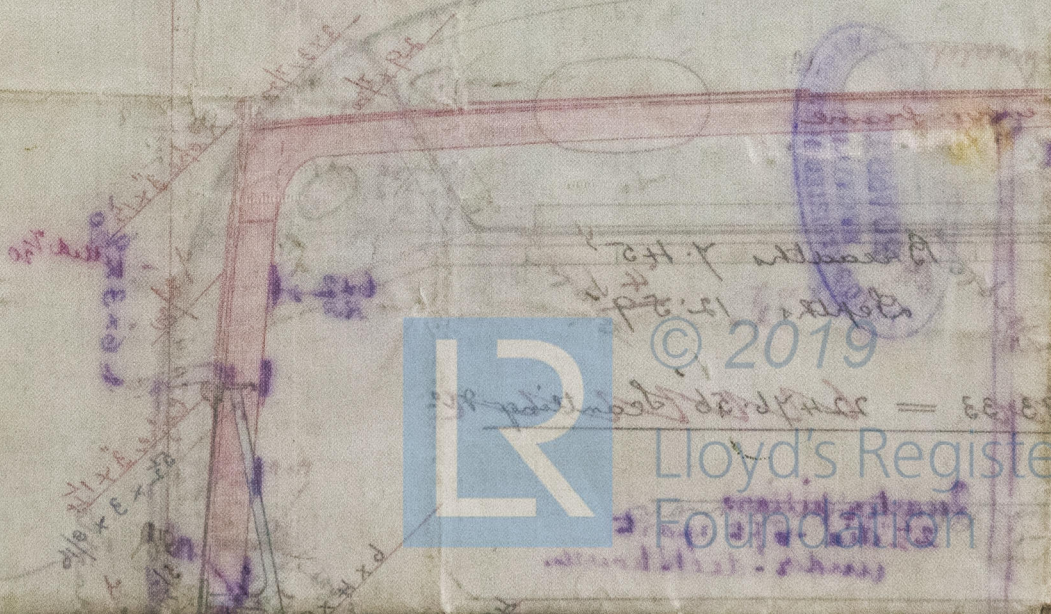


10.11.85

— 22 11 58
— (11.11)
— 11.11

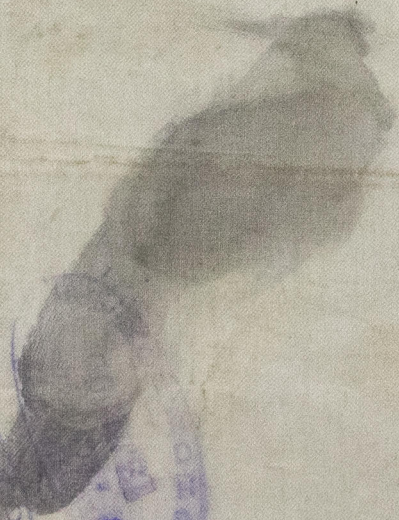

© 2019
Lloyd's Register
Foundation

— Midship Section No 66 S. S. —
— To Class 100 A. 1. ((Steel)) —
— Scale $\frac{1}{2}$ inch = one foot. —

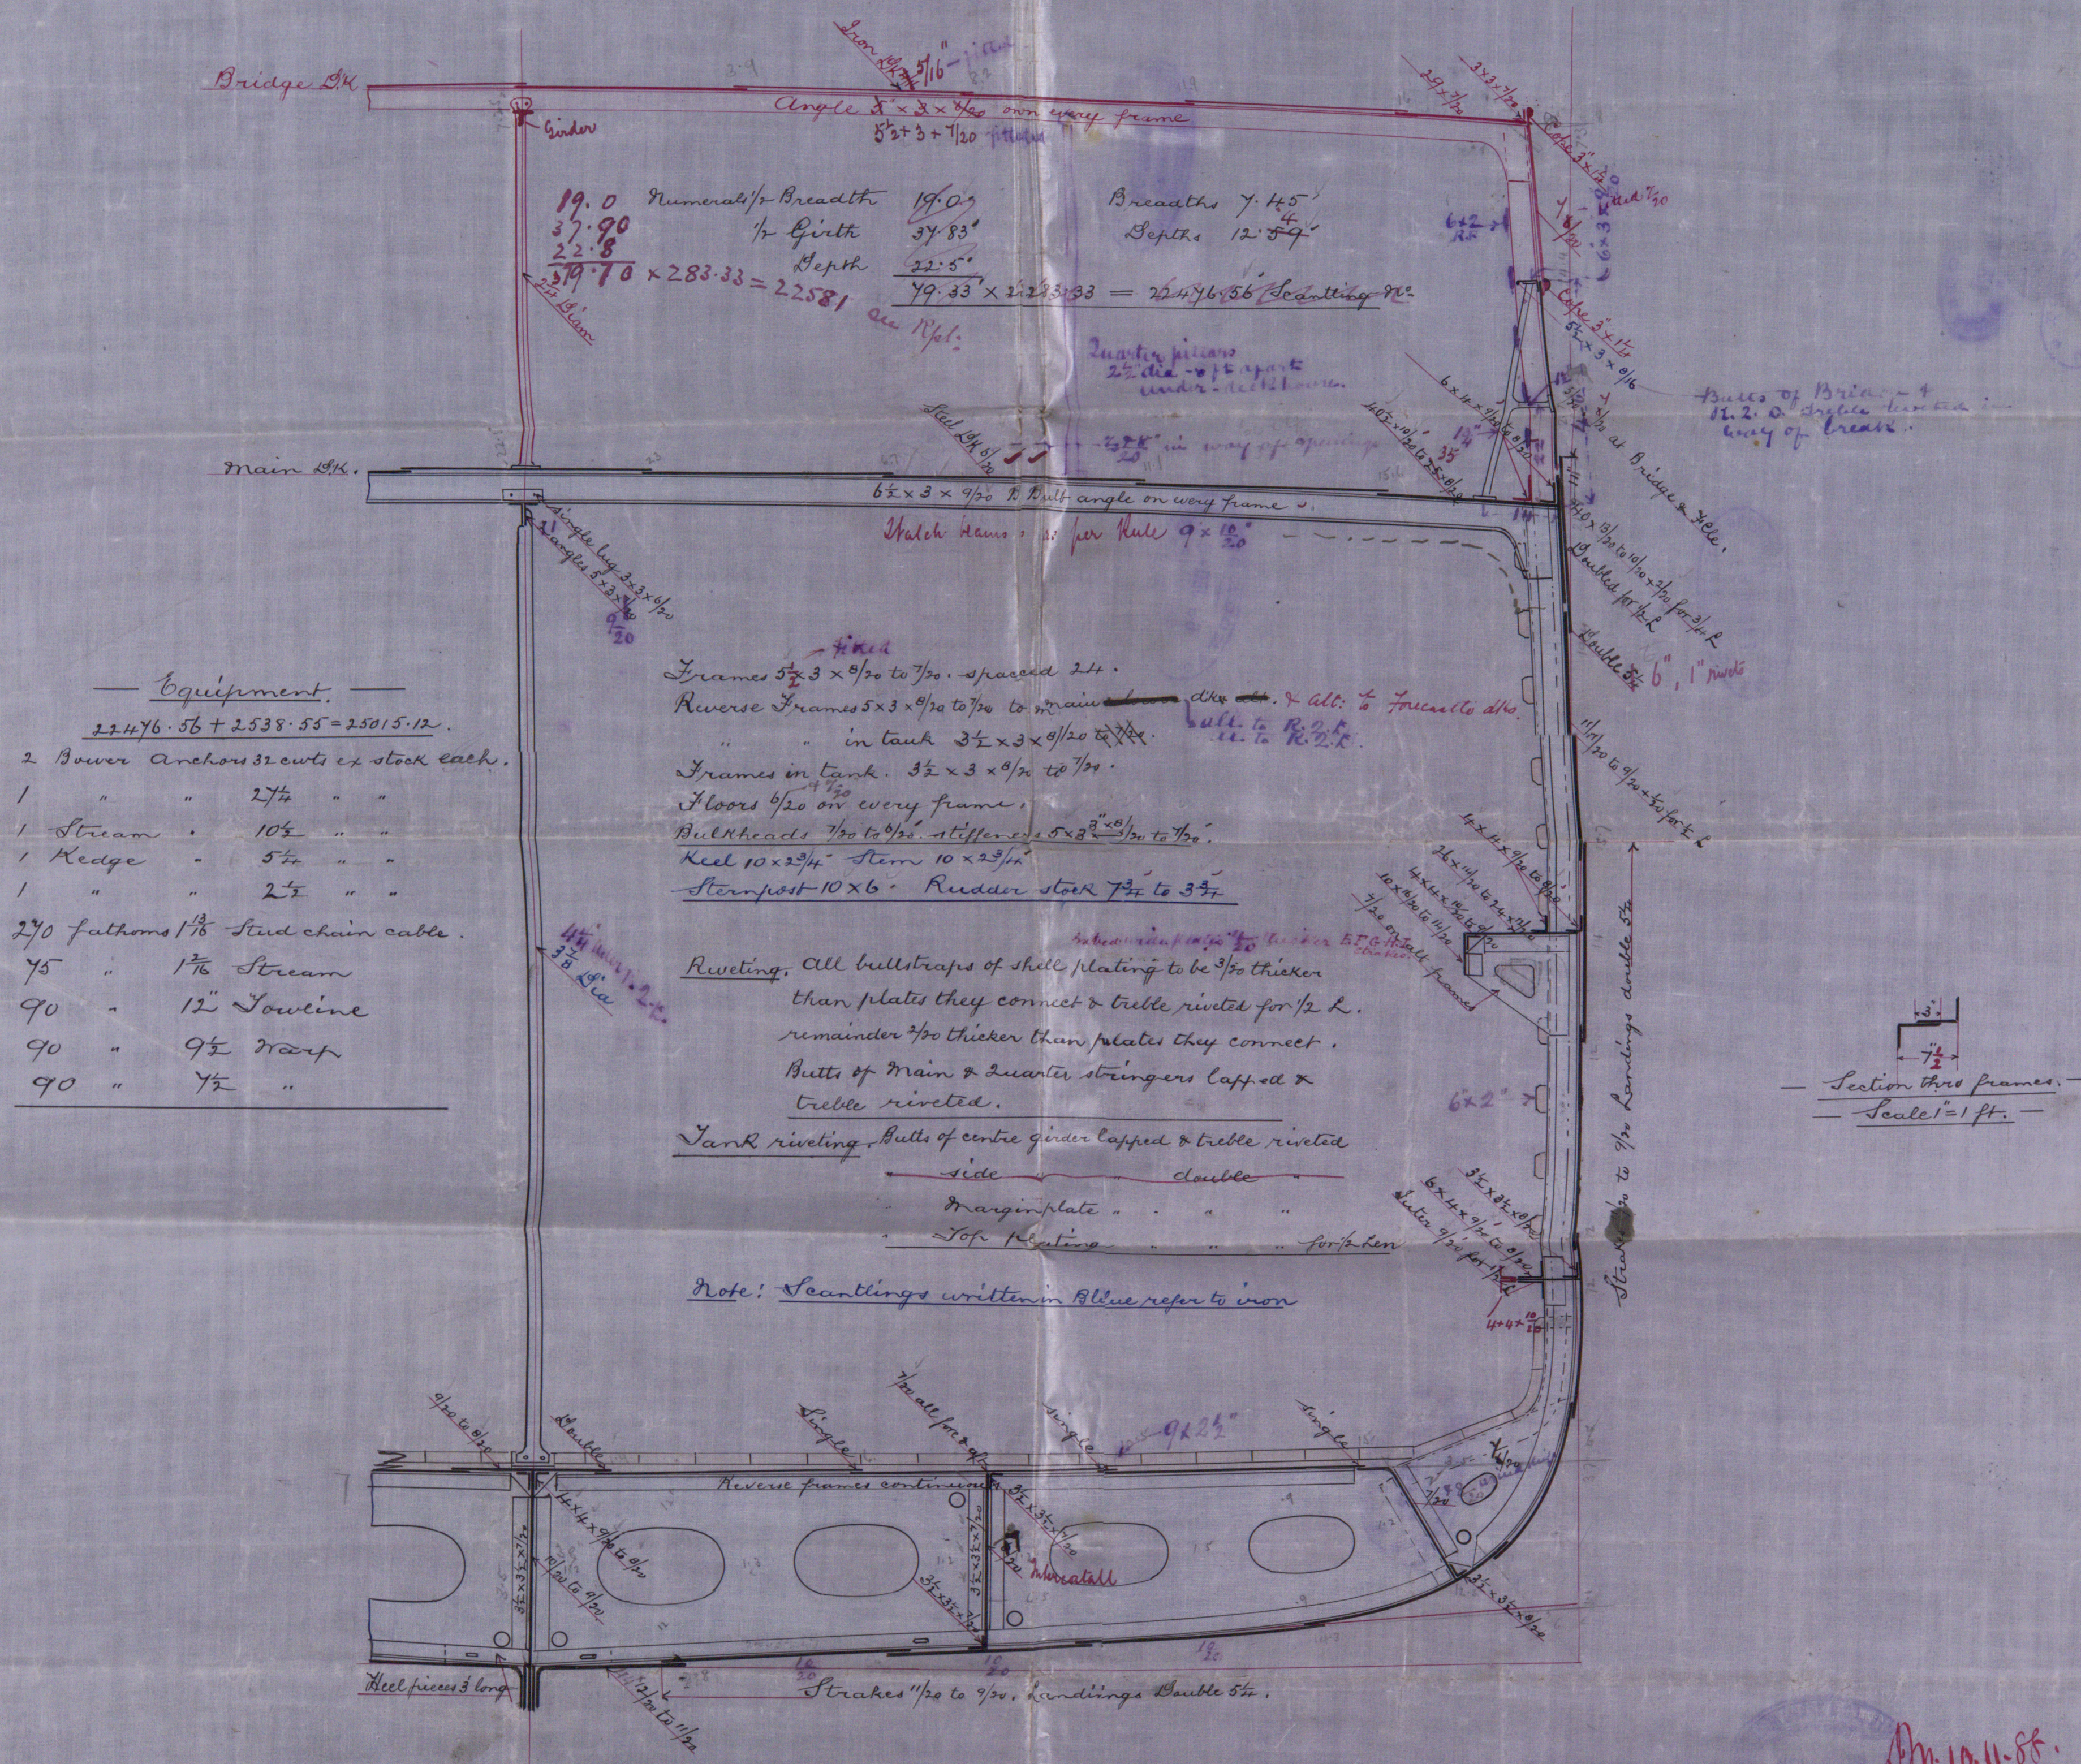

D.M. 10.11.88