



THU 10 JAN 89  
WED 30 JAN 89  
FRI 3 NOV 89

MIDSHIP SECTION

STEEL S. S. 400'-0" x 46'-0" x 32'-0" TO POPEL

N<sup>o</sup> 223

224 + 226

TO CLASS 100 A1 AT LLOYD'S 3 DECK RULE

POOP, BRIDGE & FORECASTLE

SCALE 1/2" = ONE FOOT


WED 30 JAN 89

N<sup>o</sup> 223 Alexander Elder  
Belfast Report N<sup>o</sup> 3685

NUMERALS

22.5 + 32.0 + 50.0 - 7.0 = 97.5 1<sup>st</sup> NUMERAL  
97.5 x 398.16 = 38820 PLATING  
104.5 x 398.16 + 2233 = 43340 EQUIPMENT

8.8 Breadths 12.4 Depths to Upper Deck 16.5 Depths to Middle Deck

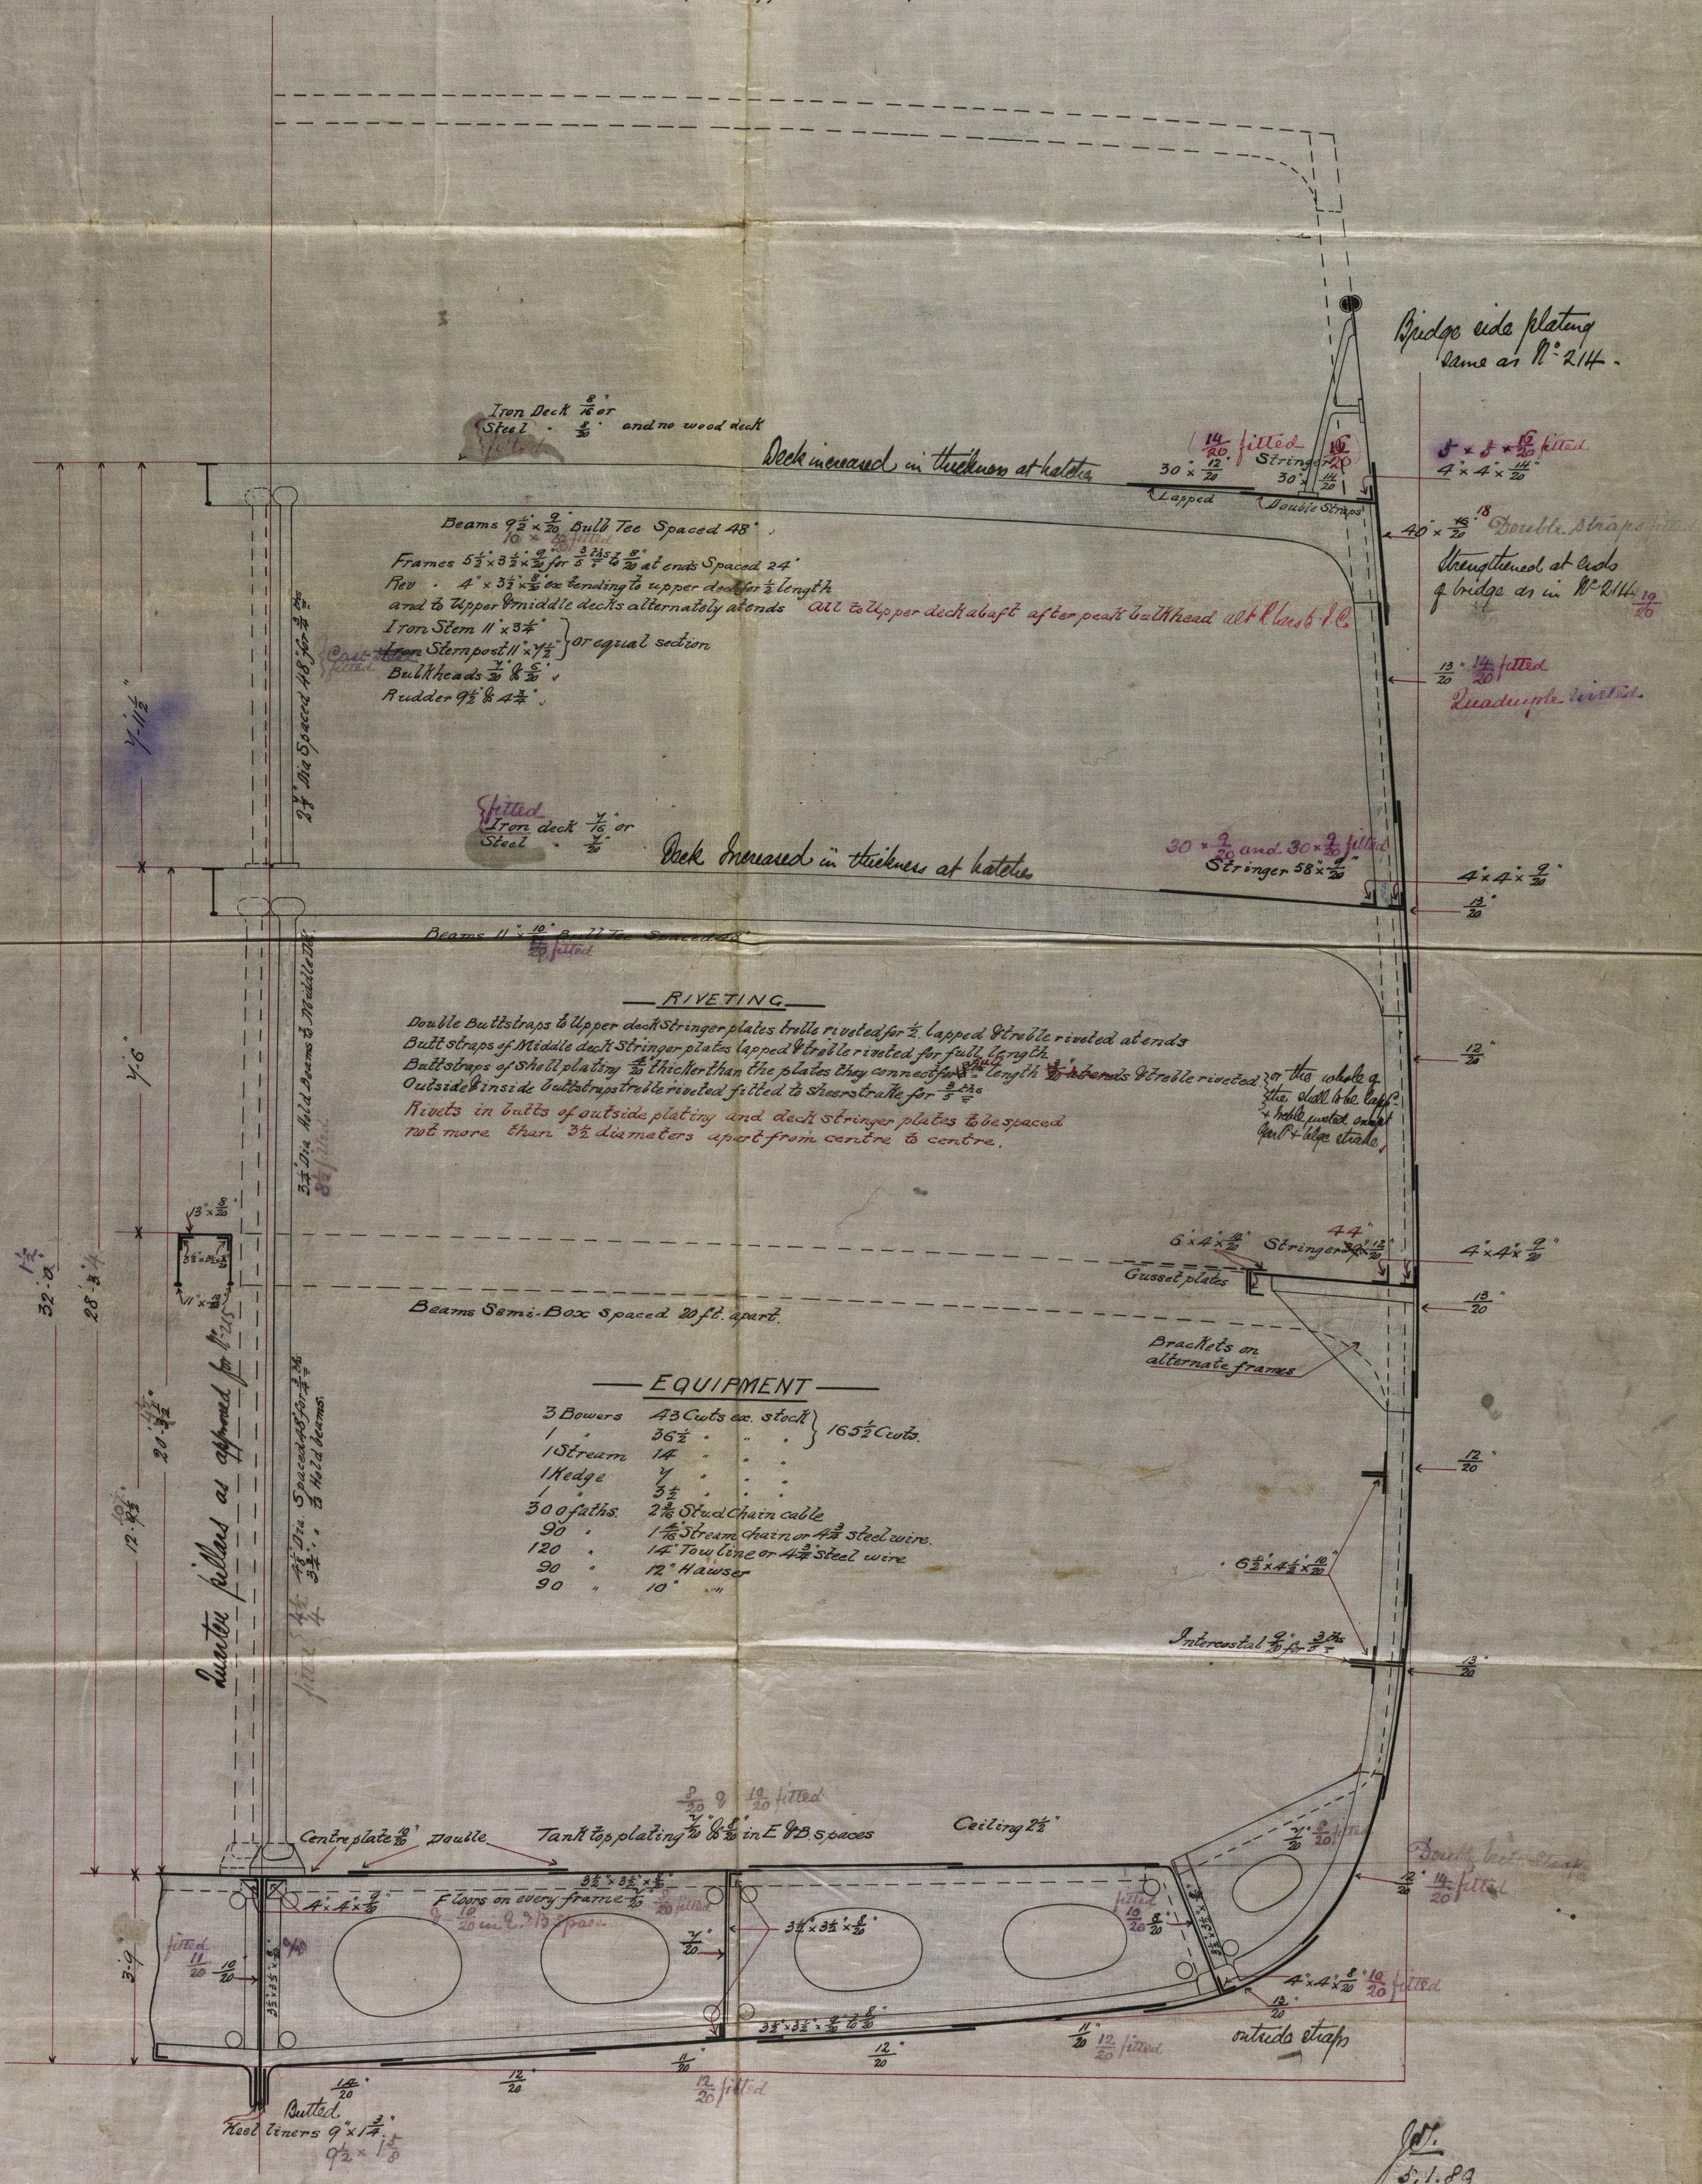

RIVETING

Double Butts of Upper deck Stringer plates to be riveted for 1/2" lapped & riveted at ends  
Butts of Middle deck Stringer plates lapped & riveted for full length  
Butts of Shell plating to be thicker than the plates they connect for 1/2" length & to be riveted  
Outside & inside butts of shell plating to be riveted for 1/2" length  
Rivets in butts of outside plating and deck stringer plates to be spaced not more than 3 1/2" diameters apart from centre to centre.

EQUIPMENT

3 Bowers	43 Cuts ex. stock	165 1/2 Cuts.
1 Stream	36 1/2 "	
1 Hedge	4 "	
500 fathoms	2 1/2" Stud Chain cable	
90 "	1 1/2" Stream chain or 1 1/2" Steel wire	
120 "	1 1/2" Tow line or 4 1/2" Steel wire	
90 "	12" Hawser	
90 "	10 "	

9/1/89

5.1.89



© 2019 Lloyd's Register Foundation

BE656-0239



S. S. Alexander Elder  
Belfast Report  
No 3605



*[Faint, mostly illegible handwritten text in the lower section of the document, possibly a list or report.]*



© 2019

Lloyd's Register  
Foundation