

Alexander Elder
Belfast Report
No. 3685

David Runcles
Belfast Report
No. 3692

28/1/89



© 2019
Lloyd's Register
Foundation


THU 10 JAN 89
WED 30 JAN 89

Nº 223. 224 + 226

SECTIONAL ELEVATION

SCALE 1/2" = 1 FOOT

WED 30 JAN

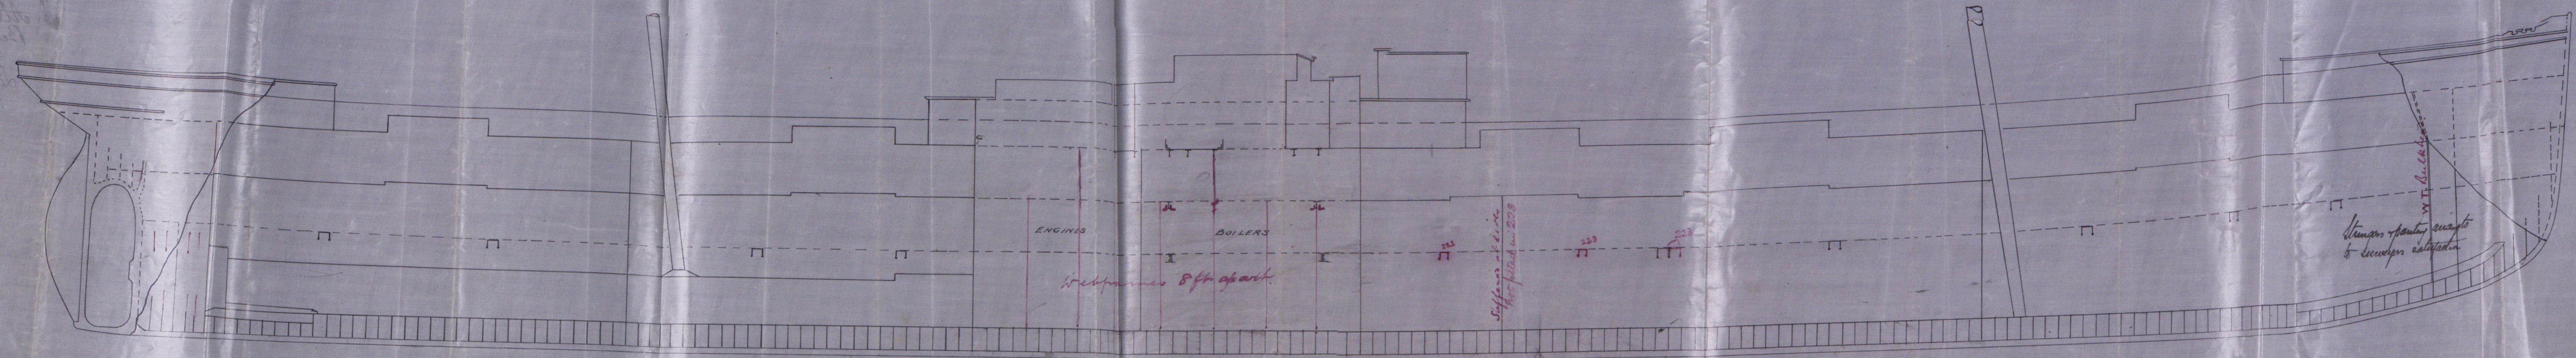

The sections on deck may
probably be shorter than shown

Nº 223. S. S. Alexander Elder
Belfast Report Nº 3685

Nº 224 S. S. Saint-Pancras
Belfast Fleetboard Report Nº 3692

Stiffeners 8 ft apart
to sections calculated

5.1.89