

Received at Belfast Office, 24 Sept. 1889.

Lloyd's Register of British and Foreign Shipping.

(Report on Vessel No. 225 Port Belfast.)

No. _____ SHIP FORGINGS OR CASTINGS.

The words FORGINGS or CASTINGS, IRON or STEEL, should be struck out as may be required.

I have to report that the undermentioned Iron or ~~Steel~~ Forgings or Castings, manufactured by The Harbour Forge Co of Irvine for the Vessel No. _____, being built by Messrs Harland & Wolff of Belfast, have been inspected by me as set forth below, and found to be, so far as can be seen, sound & efficient.

Mark on Forgings.

Lloyd's

No.


G.N.

George Newcomb
Glasgow

23/9/89

	STERN FRAME.	RUDDER FRAME.	STEM.
Material* - - -	<u>Scrap iron</u>		
How made - - -	<u>Forged</u>		
Dimensions - - -	<u>9 x 3 3/8</u>		
Progress on Inspection -	<u>Forging & smithing</u>		
Dates when Inspected	<u>7.9/8/89-4.11.20/9/89</u>		

SKETCHES OF FRAMES SHEWING POSITION AND DESCRIPTION OF WELDS OF FORGINGS, OR PARTICULARS OF TESTS APPLIED TO CASTINGS.

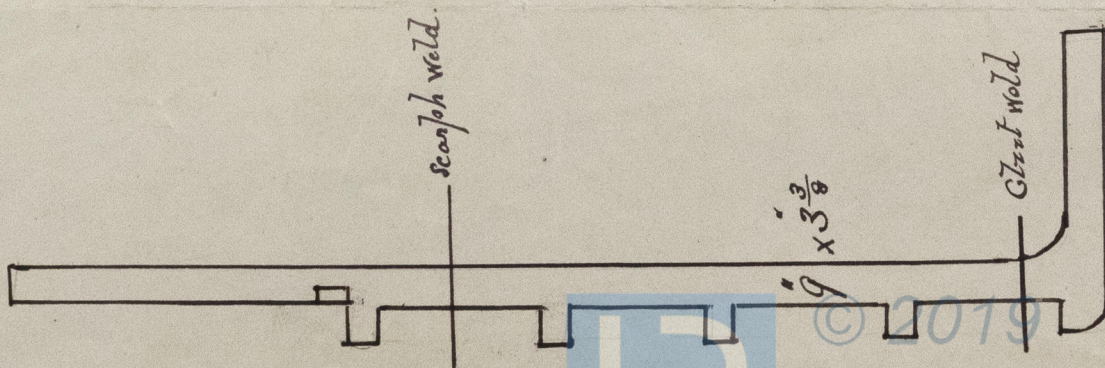

225

re ship forgings

Sept 24 1889

"California"
Belfast Report
Nº 3688

SHIP FORGINGS ON CASTINGS

© 2019

Lloyd's Register
Foundation