




THU 31 JAN 89

MIDSHIP SECTION  
No 225  
STEEL SAILING SHIP  
318'-0" x 45'-0" x 26'-6" HOLD  
TO CLASS 100A AT LLOYDS  
SCALE 1" = ONE FOOT

California  
Belfast Report  
No 3680

NUMERALS  
22.5 + 23.0 + 23.5 = 69.0 FRAMING No 97.58  
97.58 + 23.0 + 316.16 = 326.74 PLATING No 30850  
30850 + 205.6 + 205.6 + 205.6 = 720.3 EQUIPMENT No 32906  
7.07 Breadths; 10.8 Depths

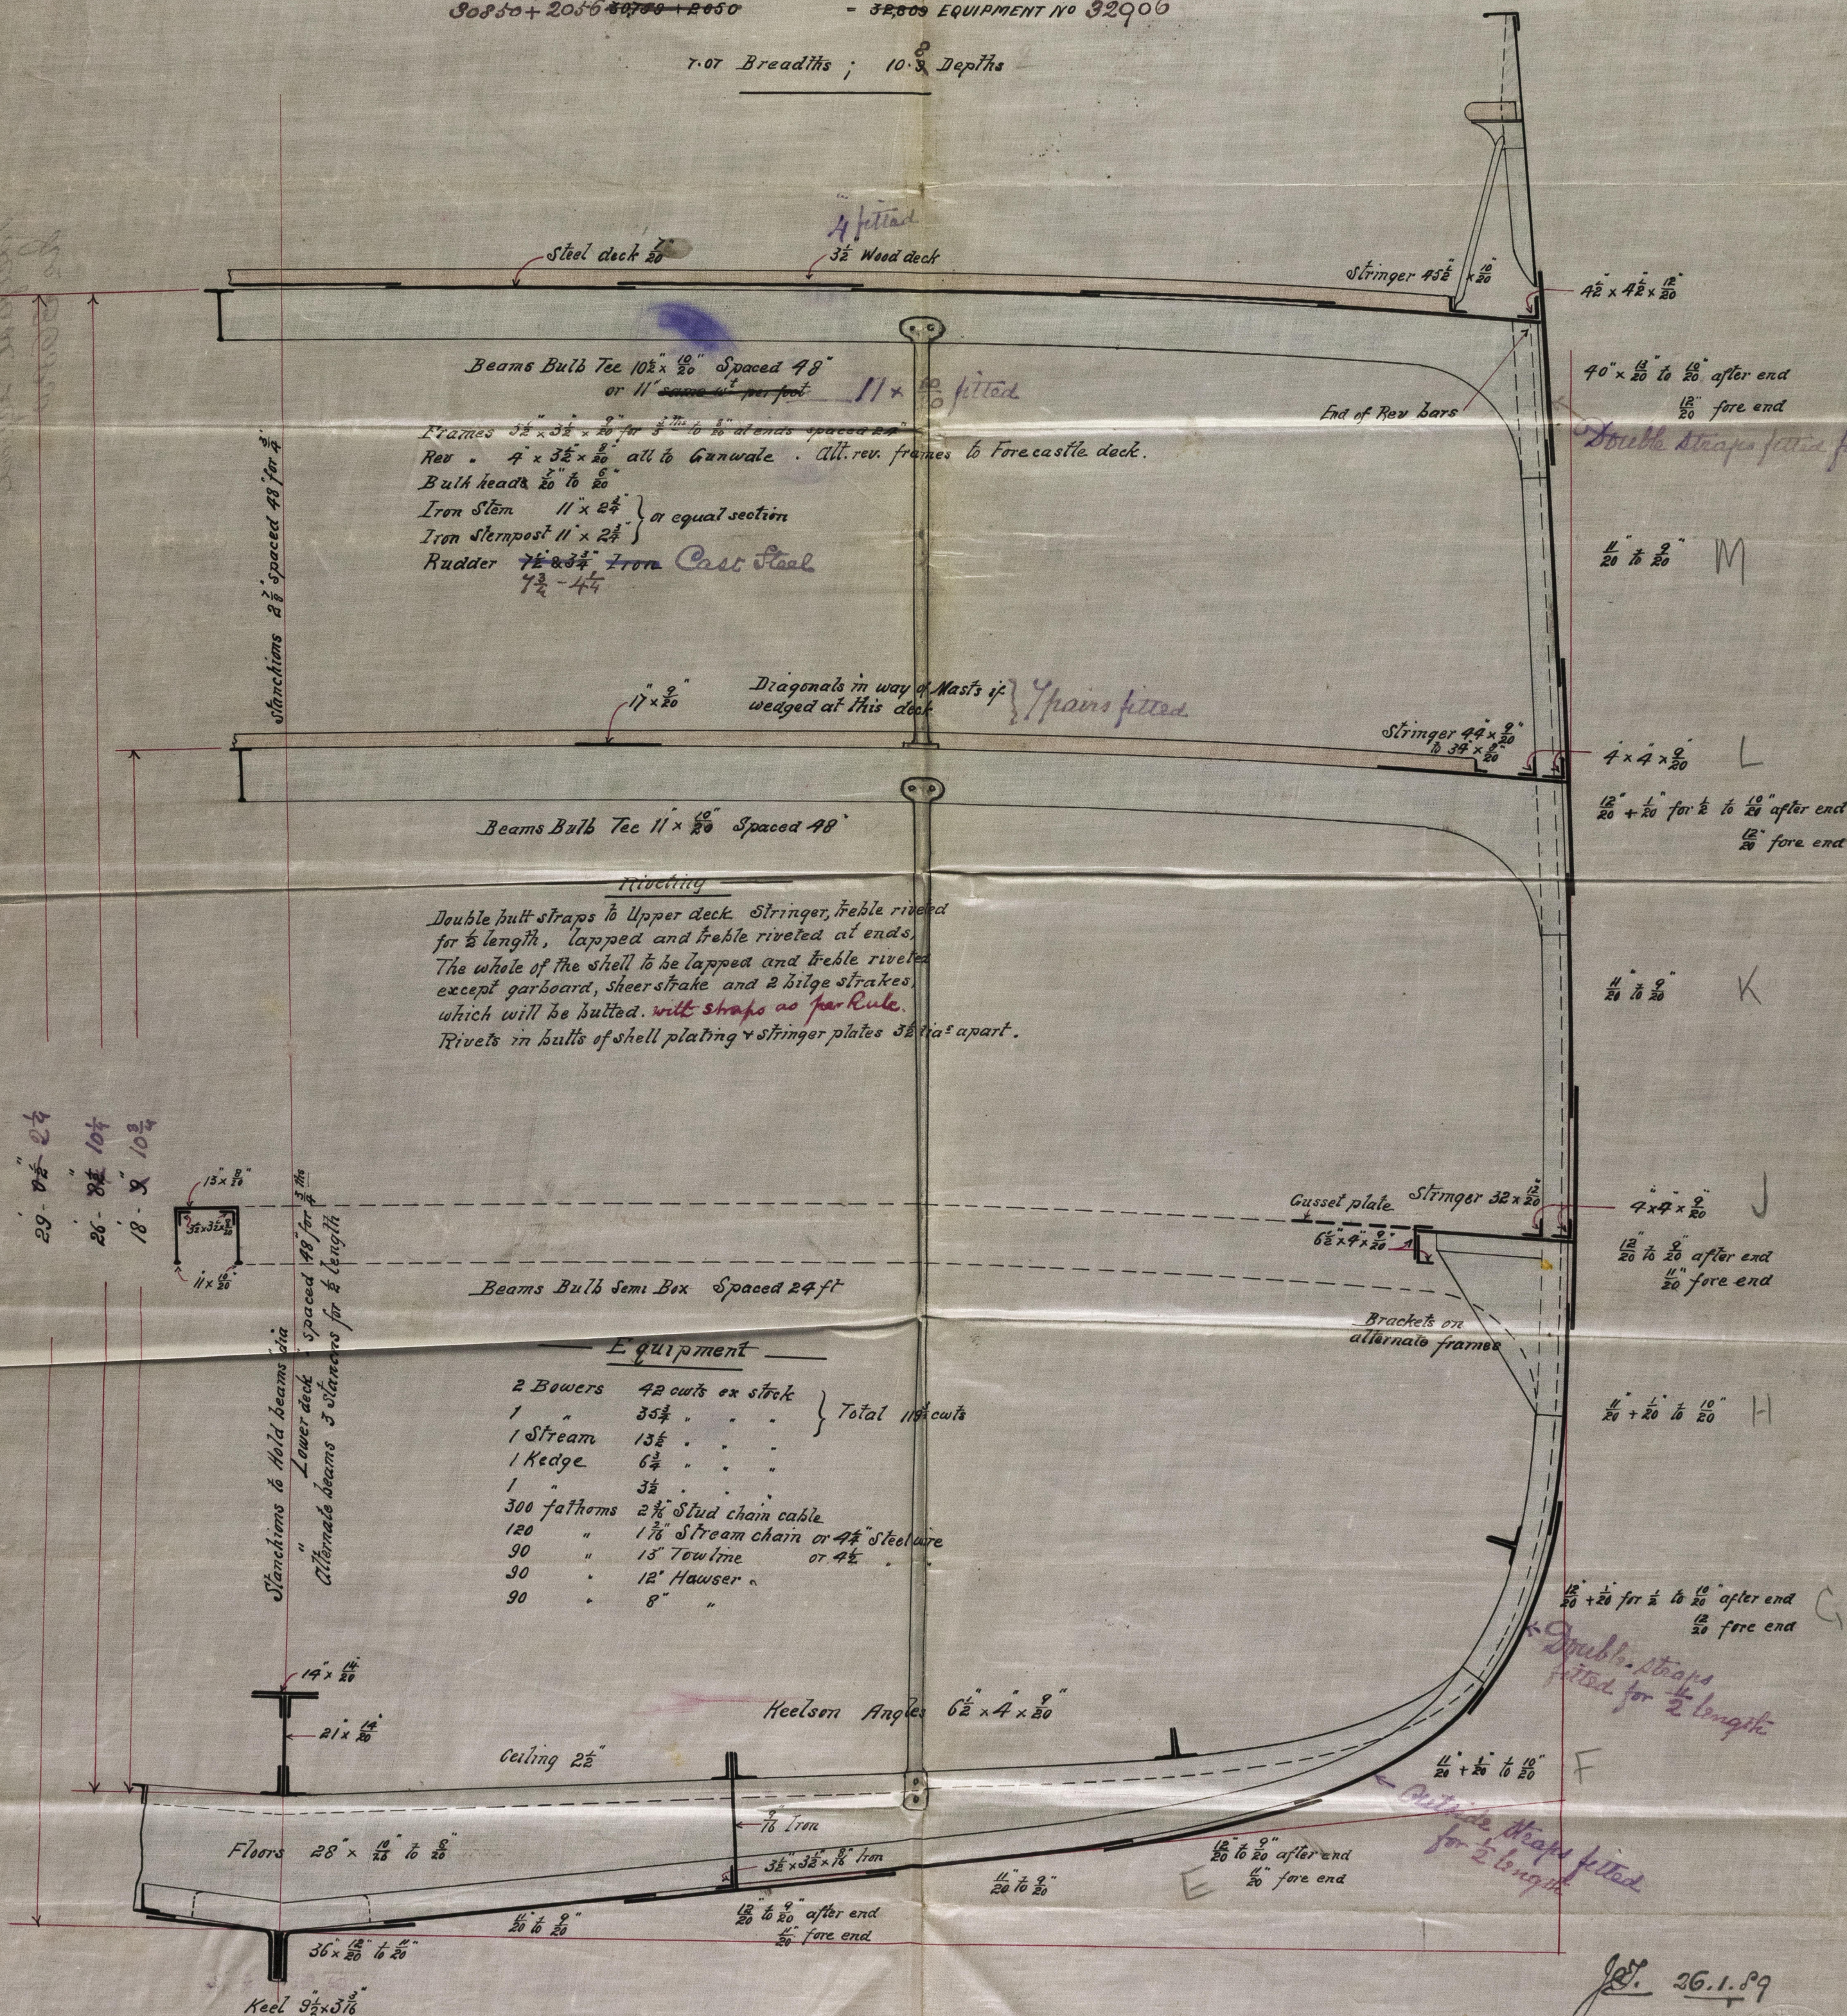

29/1/89

26.1.89



California  
Belfast Lep  
No 3600

Stratons ...

Alternate ...

Boone Bill for 102

300 for ...  
120 ...  
90 ...  
90 ...  
90 ...  
12 ...

30000 + 5000 ...  
20000 x 3 1/2 = 70000

Y-01

Readings

© 2019  
Lloyd's Register  
Foundation