




THU 4 JUL 89
SAT 13 JUL 89

S.S. Strait Ticker
Belfast Report No 3700

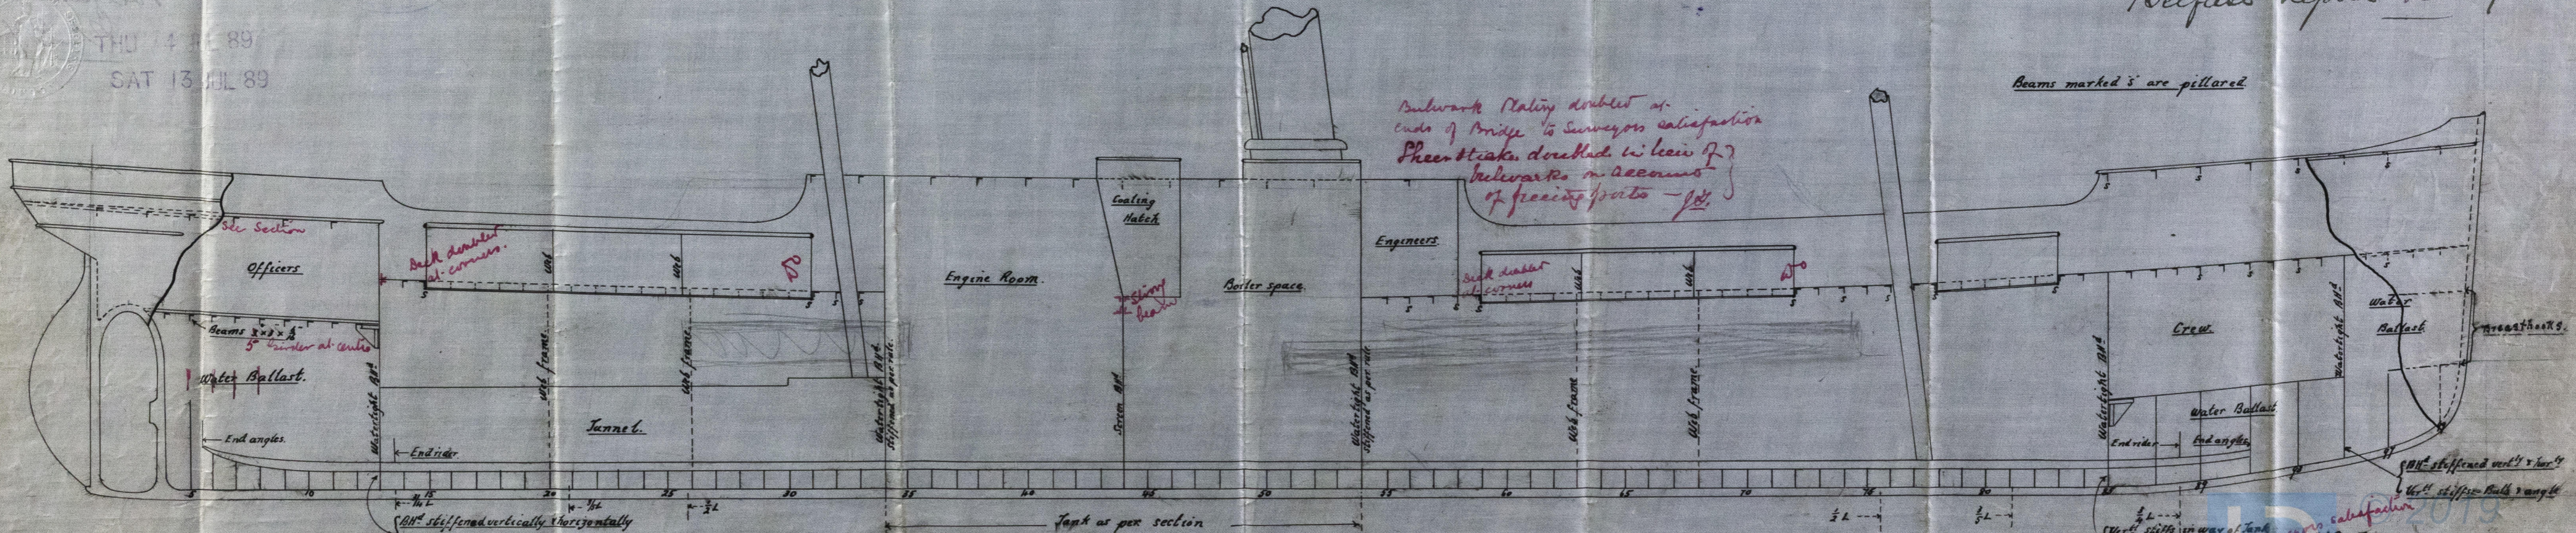

Bulwark Plating doubled at ends of bridge to Surveyors satisfaction
Sheer strake doubled in lieu of bulwarks on account of freeing ports - J.C.

Beams marked 5 are pillared


Web stiffened vertically & horizontally
Vertical stiff's: Bulb angle
to Surveyors satisfaction

50H" stiffened vert' & hor'
6H" stiff's - Bulb angle
Vert' stiff's in way of Tank
Bulb angle
to Surveyors satisfaction
No 40

MAGILWAINE & MACCOLL,
LIMITED
No 1003-25-6-89
SHIP BUILDERS AND ENGINEERS
BELFAST.

29.6.89

Longitudinal Section.
Scale 8" = 1 foot.
Lloyd's Register
Foundation
BEL 57-0016

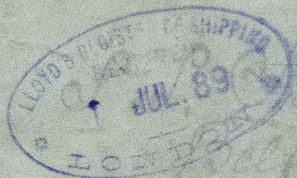

Strait Ticker
Belfast Report
N^o 3708




© 2019

Lloyd's Register
Foundation

BEL57-0016