

Received at Belfast office, 26 Oct 1889

Lloyd's Register of British and Foreign Shipping.

(Report on Vessel No. 40 Port Belfast)

No. 2311 SHIP FORGINGS ~~OR CASTINGS~~.

The words FORGINGS or CASTINGS, IRON or STEEL, should be struck out as may be required.

I have to report that the undermentioned Iron ~~or Steel~~ Forgings ~~or Castings~~, manufactured by The Portland Forge Coy of Kilmarnock for the Vessel No. 40, being built by Messrs MacSwaine & Maccol of Belfast have been inspected by me as set forth below, and found to be, so far as can be seen, sound & efficient

Mark on Forgings.


Lloyd's  
No. 2311  
W H

William Hamilton

Glasgow  
25/10/89

	STERN FRAME.	RUDDER FRAME.	STEM.
Material*	<u>Scrap iron</u>		/
How made	<u>Forged</u>		
Dimensions	<u>7 x 3 1/2</u>		
Progress on Inspection	<u>Forging &amp; smithing</u>		
Dates when Inspected	<u>16.18.24/9.89.2.11.24/10/89</u>		

SKETCHES OF FRAMES SHEWING POSITION AND DESCRIPTION OF WELDS OF FORGINGS, OR PARTICULARS OF TESTS APPLIED TO CASTINGS.

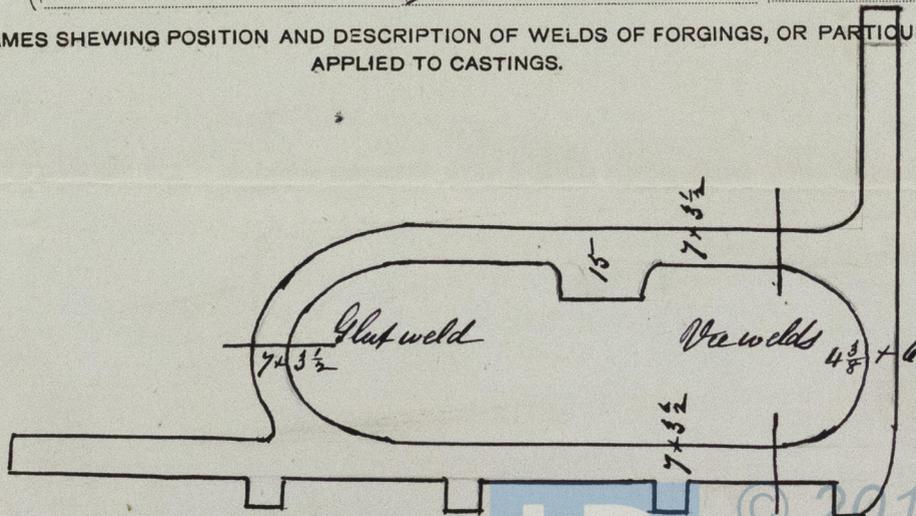

M. J. 40

re. Ship forgings on stern frame

Belfast 26 1889

S. S. "Strait Fisher"  
Belfast Report  
No. 3700



© 2019

Lloyd's Register  
Foundation