

Received at Belfast Office, 21 Feb, 18 90

# Lloyd's Register of British and Foreign Shipping.

(Report on Vessel No. 59 Port Belfast)

## No. 1227a SHIP FORGINGS OR CASTINGS.

I have to report that the undermentioned Iron or ~~Steel~~ Forgings or Castings, manufactured by the Darlington Forge Co. of Darlington for the Vessel No. 59, being built by Messrs Workman Clark & Co. of Belfast have been inspected by me as set forth below, and found to be, so far as can be seen, sound.

Mark on Forgings.


Lloyd's

No. 1227a  
16. C.

Wm Cameron  
Sunderland  
20. 2. 90

	STERN FRAME.	RUDDER FRAME.	STEM.
Material* - - -	<u>Scrap iron</u>		
How made - - -	<u>Forged</u>		
Dimensions - - -	<u>11 x 4 1/2"</u>		
Progress on Inspection -	<u>Forged &amp; Printed</u>		
Dates when Inspected	<u>Feb 13-16-20-27 March 6-14</u> <u>22-27 April 5-12-16-26/89</u>		

SKETCHES OF FRAMES SHEWING POSITION AND DESCRIPTION OF WELDS OF FORGINGS, OR PARTICULARS OF TESTS APPLIED TO CASTINGS.

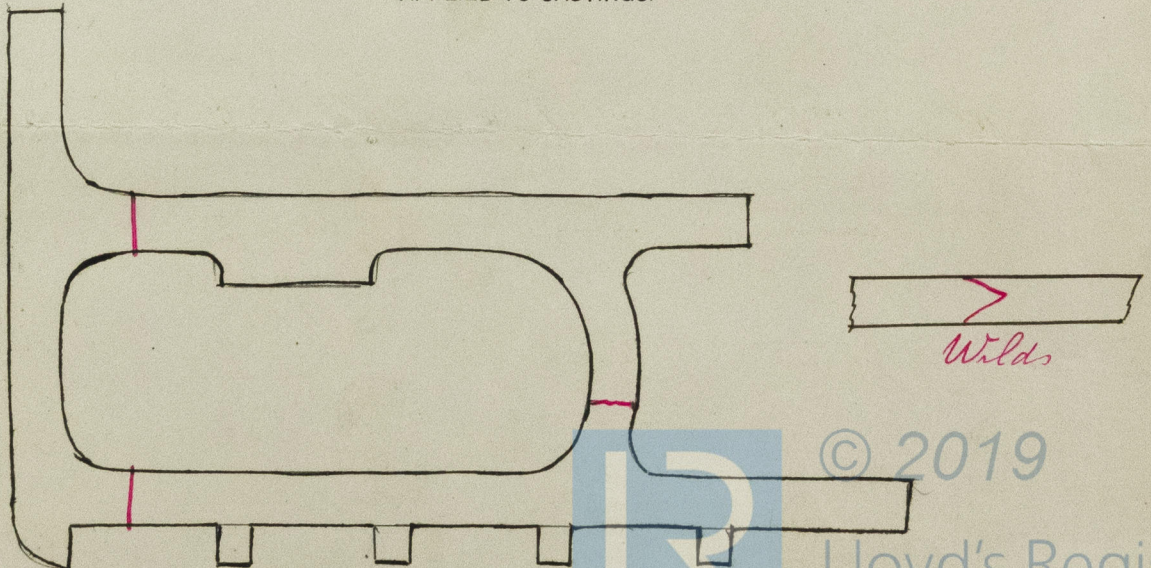



W. & L. N<sup>o</sup> 59

Ship forgings

Stern Frame

21-2-90

S.S. City of Vienna

Bel Rept N<sup>o</sup> 3714



© 2019

Lloyd's Register  
Foundation