


THU 6 JUN 89
FRI 18 OCT 89

S.S. Michigan
Belfast Harbour Report
No 3712
First Entry Report No 3710

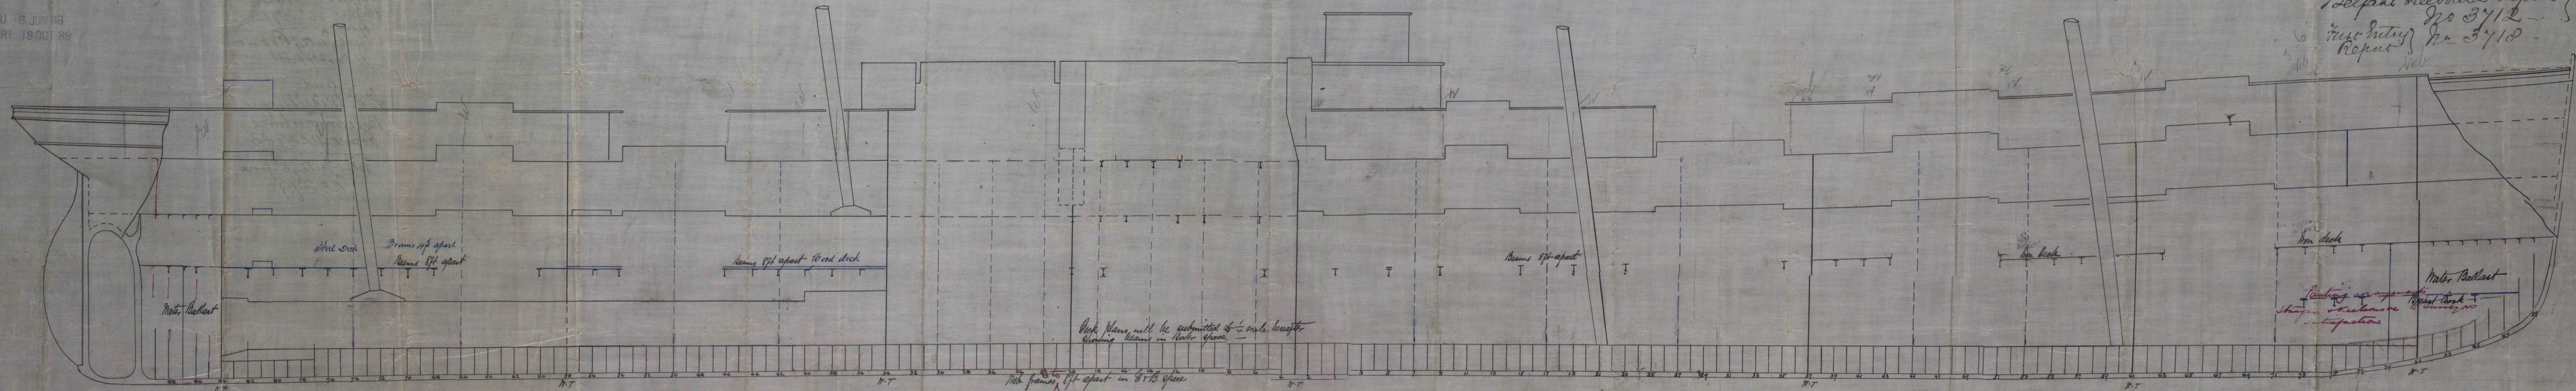

SECTIONAL ELEVATION No 227

SCALE 1/4 INCH = 1 FOOT

No 231
No 238

FRI 18 OCT 89



29/5/89

J.C. 13.5.89

BEL-57-0052

S. S. Michigan
Belfast Freeboard
Report No. 3712
First Entry Report
No. 3712

and
S. S. Mississippi
Belfast Freeboard
Report No. 3713
First Entry Report
No. 3713



© 2019
No. 21 OCT. 39

RECEIVED

Lloyd's Register
Foundation