


THU 16 JUN 89  
FRI 18 OCT 89

No 227, No 231, No 238  
S.S. 370 x 44 x 30.6 (KEEL TO BEAMS)  
SCALE  $\frac{1}{8}$ " = ONE FOOT

FRI 18 OCT 89

S.S. "Michigan"  
Belfast Freeboard Report No 3412  
"First Entry" No 3410

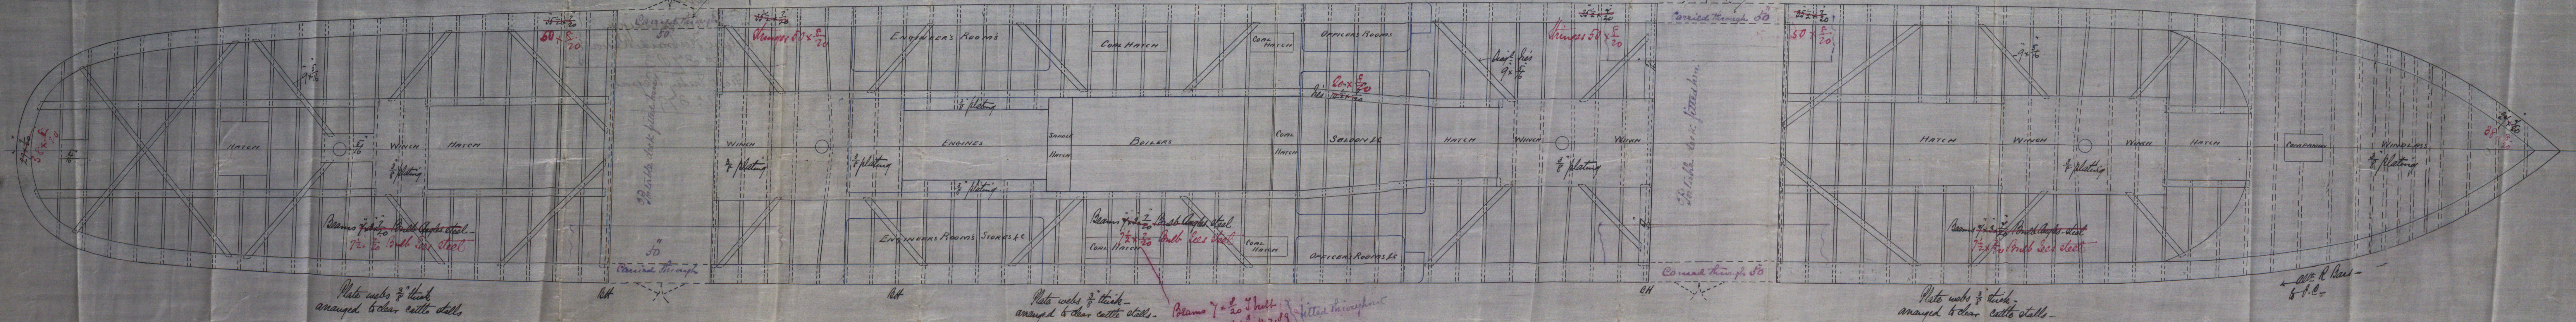

Scantlings of Poop, bridge & Forecastle to be as required for Awaiting decks.

25/6/89  
B.E.  
SHIPBUILDERS & W.

27.5.89



L. S. Michigan  
Belfast Freeboard Report  
No. 3712

First Entry Report  
No. 3710

and

L. S. Mississippi  
Belfast Freeboard Report  
No. 3703

First Entry Report  
No. 3790



© 2019

Lloyd's Register  
Foundation

BEL57-0854