


Handwritten notes:
 1. 2. 

NS 227; No 231; & No 238
 S. S. 370 x 44 x 30.5 (KEL 1000000)
 SCALE 1/2" = ONE FOOT

S.S. "Michigan"
 Belfast Harbour Report No 3712
 First Entry No 3710

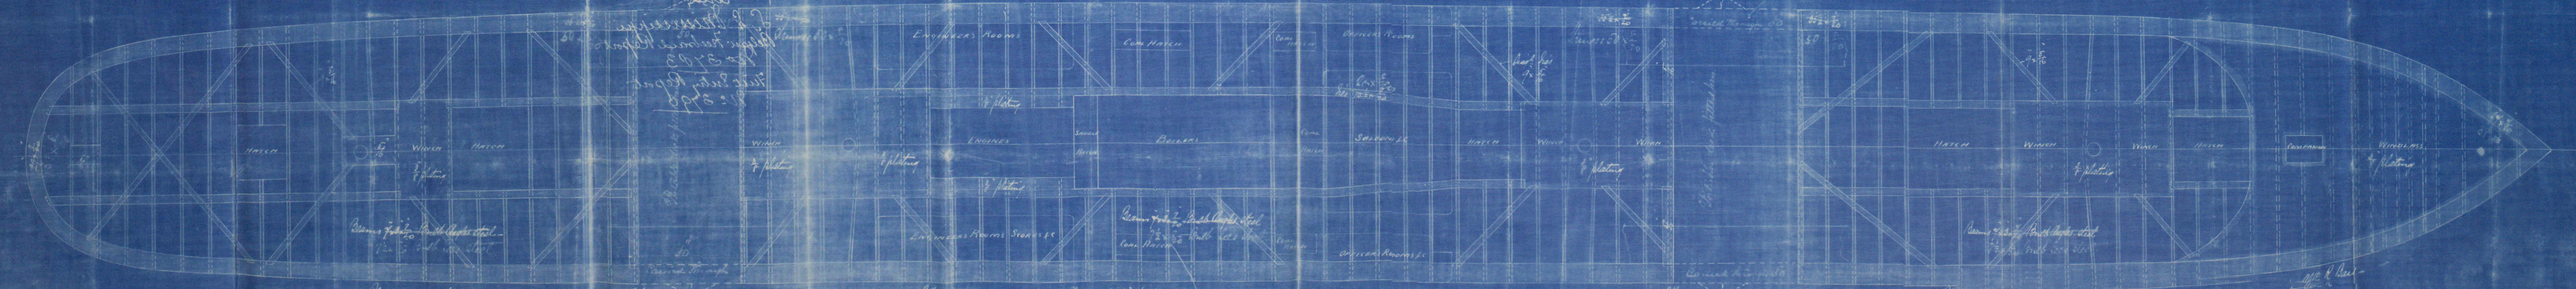

Water tanks 3' thick
 arranged to clear cattle stalls





BEL 57-0062