
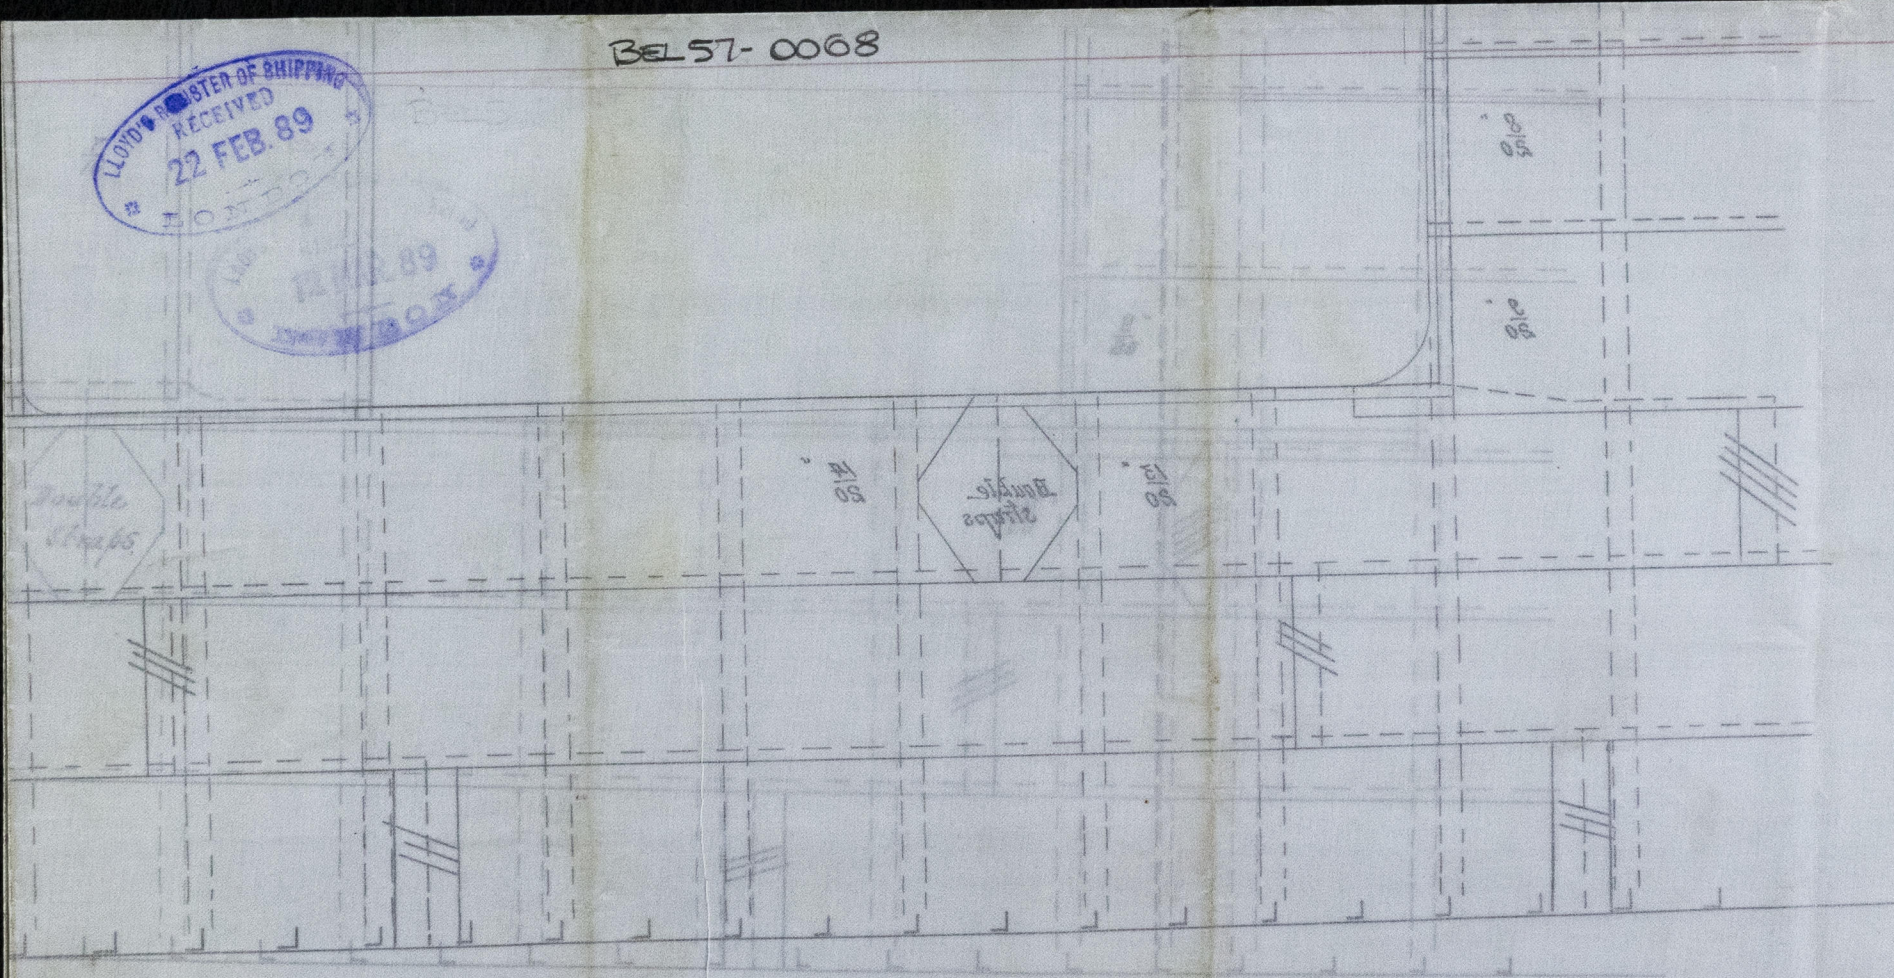


BE 57-0068

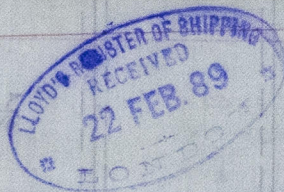

*S.S. British Empire*  
*Delft Report*  
*No 30-13*

— No 514 —

— UPPER DECK PLAN —

Scale 1/2" = 1 Foot

*23/1/89*



© 2019

Lloyd's Register  
Foundation