


Scale  $\frac{1}{8}$  in. = 1 ft.

S. S. "Glenam"  
Belfast Report No 3730

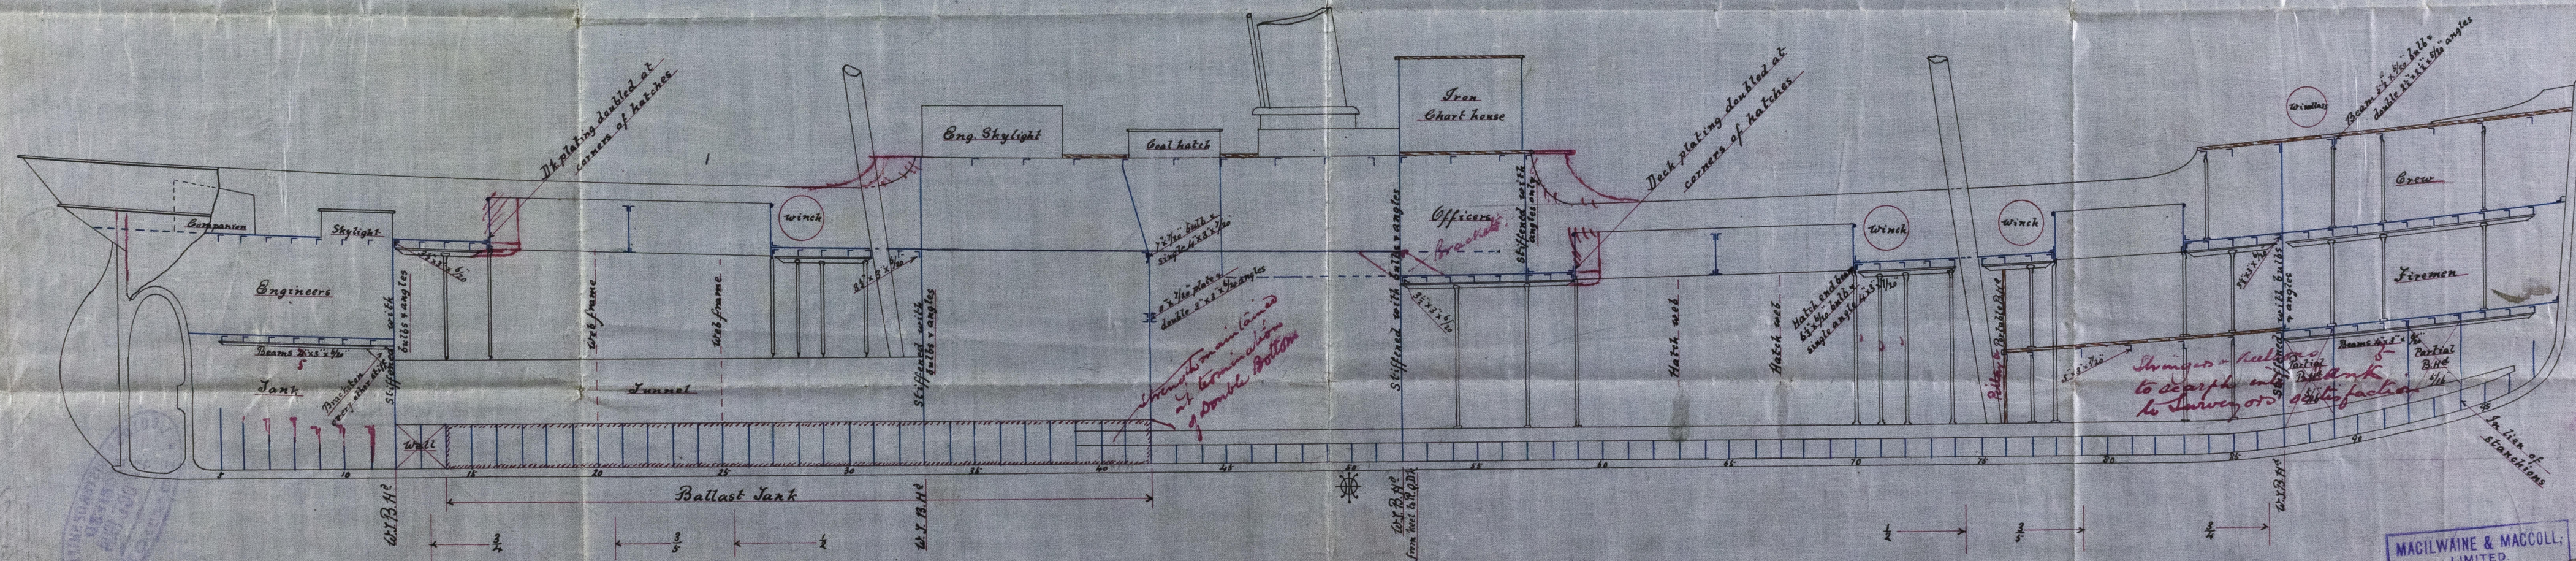

MACILWAINE & MACCOLL;  
LIMITED.  
No 1212. 23-10-8  
SHIP BUILDERS AND ENGINEERS,  
BELFAST.

24.10.89

Lloyd's Register Foundation

BEL 57- 0089

J.V.L.  
29/10/89



L. S. Glenariff.  
Belfast Report  
No. 373 D



BEL 57-0089

SHAW

© 2019

Lloyd's Register  
Foundation

BEL 57-0089