


# PARTICULARS FOR RECORD OF MOULDED DEPTH IN LLOYD'S REGISTER.

Port *Belfast* Date *July 22<sup>nd</sup> 1890*

Not in Reg. Book - Name of Vessel *"Glenam"*

Description of Vessel } *One deck, with long P. 2<sup>nd</sup> DR*  
1, 2, 3, Dk. or Awning Dk., &c.

The following measurements have been taken personally by the undersigned  
at the Middle Line Amidships.

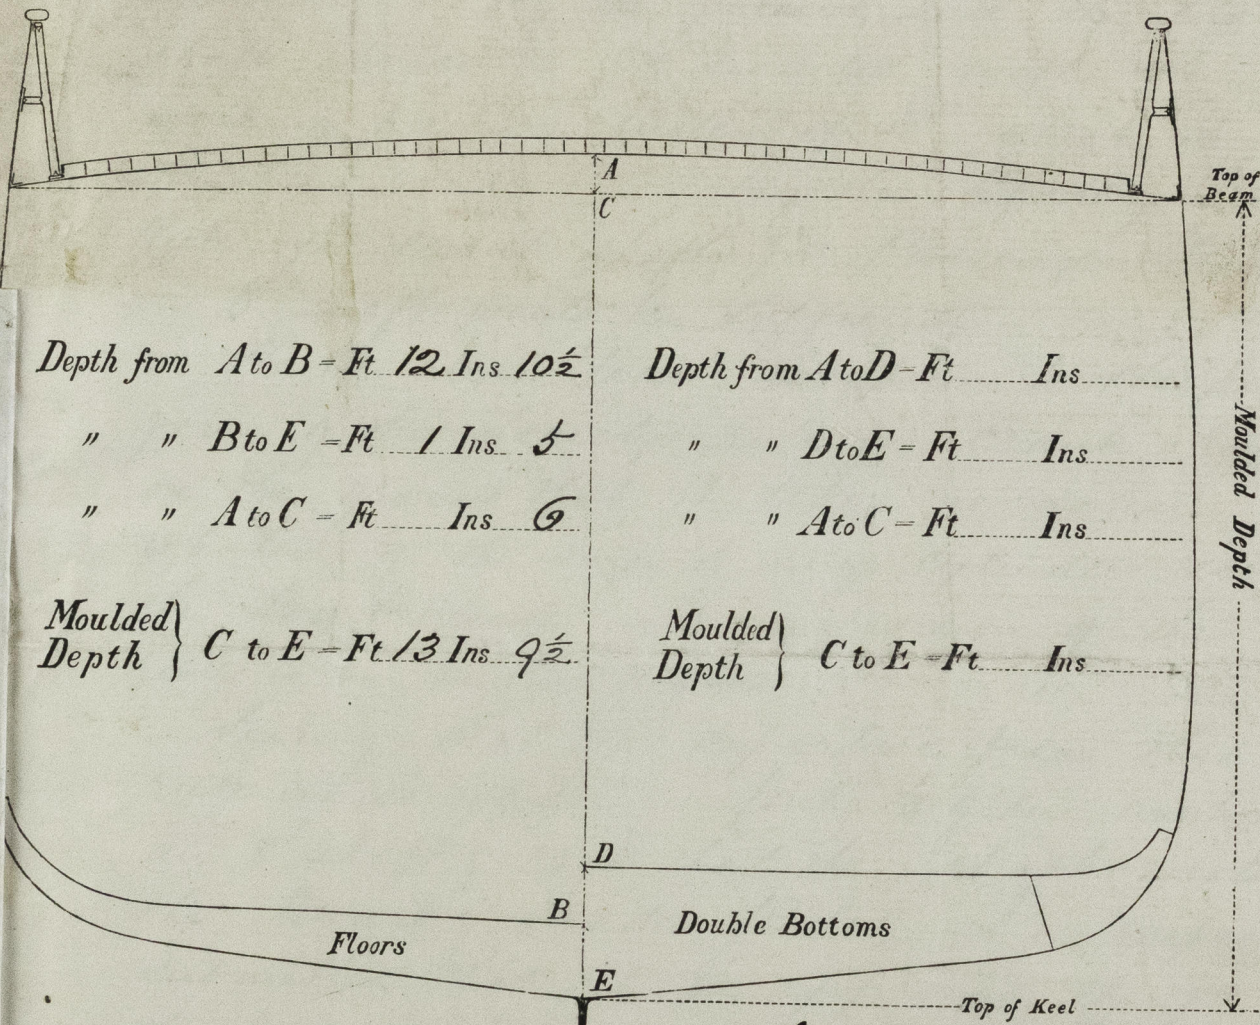

*James Curpin*

Surveyor to Lloyd's Register of British and Foreign Shipping.

In one, two, or three decked Vessels, the depth from A to B is to be measured from top of upper deck beam amidships, to the top of floors.

In Spar or Awning Decked Vessels, the depth from A to B is to be measured from top of Main Deck beam amidships, to top of floors.

In Vessels fitted with Double Bottoms of any description, the depth is to be measured from the height as above described to the top of inner bottom plating, A to D.

Depth from B to E, and A to E. Is to be the depth of floors or of Double Bottoms of any description.

Depth from A to C. Is the round up of midship beam.


Level with the top of keel on each side, care being taken to measure on both sides to prevent error through the Vessel not being quite upright.