


TUE 30 APR 89

Section through Bridge deck N° 67 S S

Scale $\frac{1}{2}'' = 1 \text{ foot}$.

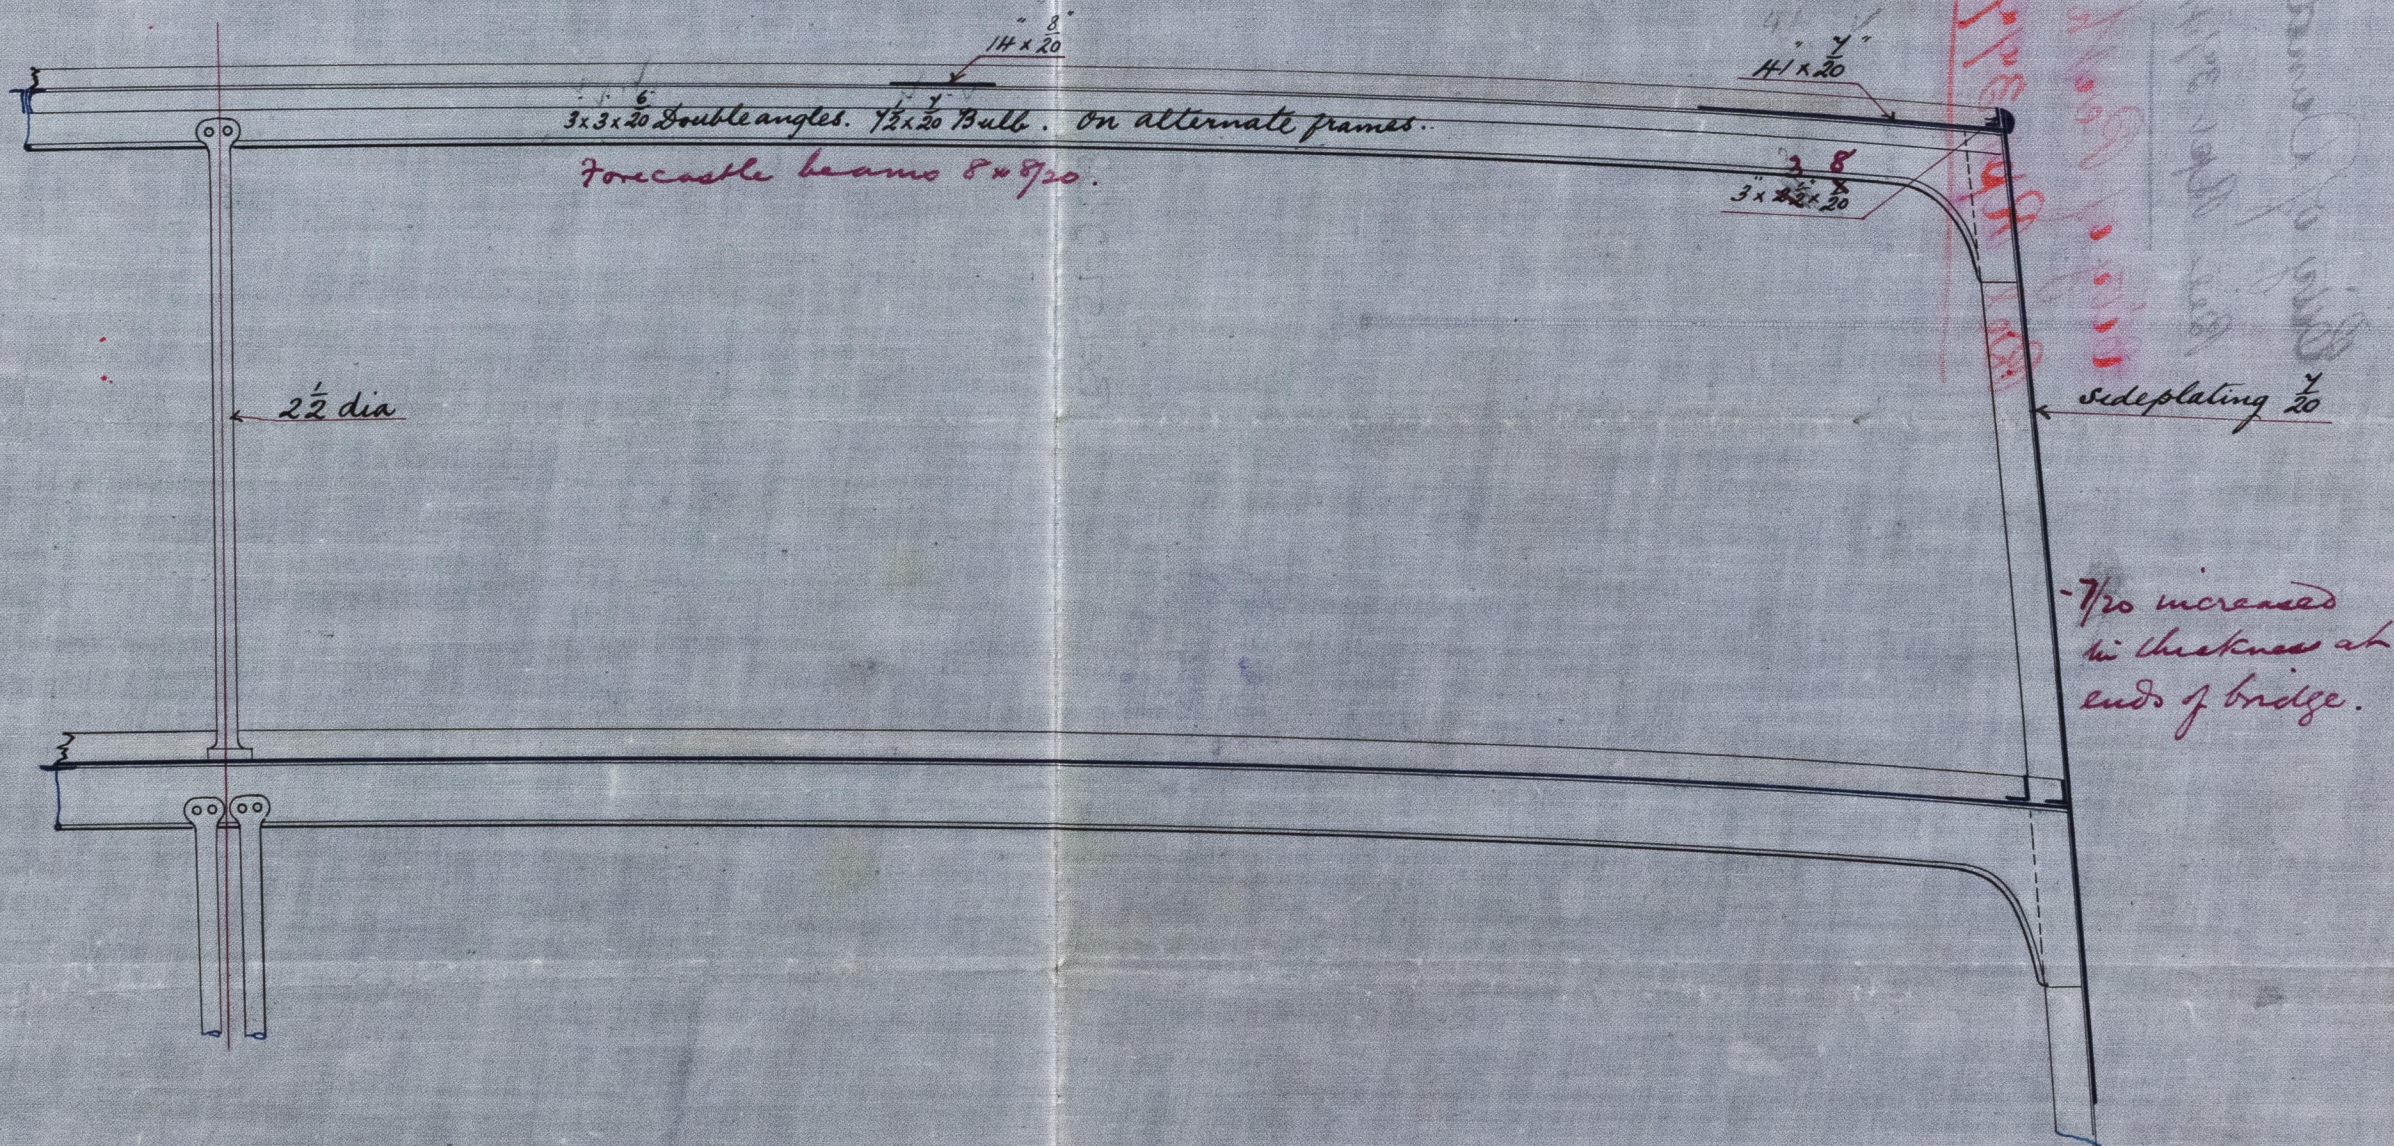

J.H.L.
29/4/89



© 2019
Lloyd's Register
Foundation

BE 57-0108

8010-17-45

W. J. H. - ed

W. J. H.
2/2/45

W. J. H.
2/2/45

City of Dundee

Rel Rpt 3rd/41

City of Perth

Rel Rpt 3rd/44



© 2019

Lloyd's Register
Foundation

BEL57-0108