

Received at Belfast Office, 17-4- 1890.

Lloyd's Register of British and Foreign Shipping.

Belfast

(Report on Vessel No. _____ Port _____)

No. 1434a.

SHIP FORGINGS OR CASTINGS.

I have to report that the undermentioned Iron or Steel Forgings or Castings, manufactured by

The Darlington Forge Co. of Darlington

for the Vessel No. 67, being built by Messrs Workman Clark & Co.

of Belfast have been inspected by me as set forth below, and found to be, so far as can be seen, sound.

Mark on Forgings.

Lloyd's

No. 1434a


R.C.

Hugh Cameron

Sunduland 16/4/90

	STERN FRAME.	RUDDER FRAME.	STEM.
Material* - - - -	<u>Scrap iron</u>	<u>Scrap iron</u>	
How made - - - -	<u>Forged</u>	<u>Forged</u>	
Dimensions - - - -	<u>11" x 7 1/2"</u>	<u>9 1/2" - 4 1/2"</u>	
Progress on Inspection -	<u>Forged & Smithed</u>	<u>Forged & Smithed</u>	<u>Not seen</u>
Dates when Inspected	<u>Sept 110-14-23 Oct 1-4-7</u> <u>11/89</u>	<u>Jan 8-14-18 Feb 1-12-17-24</u> <u>March 5-11-19-24 April 5-11/90</u>	

SKETCHES OF FRAMES SHEWING POSITION AND DESCRIPTION OF WELDS OF FORGINGS, OR PARTICULARS OF TESTS APPLIED TO CASTINGS.

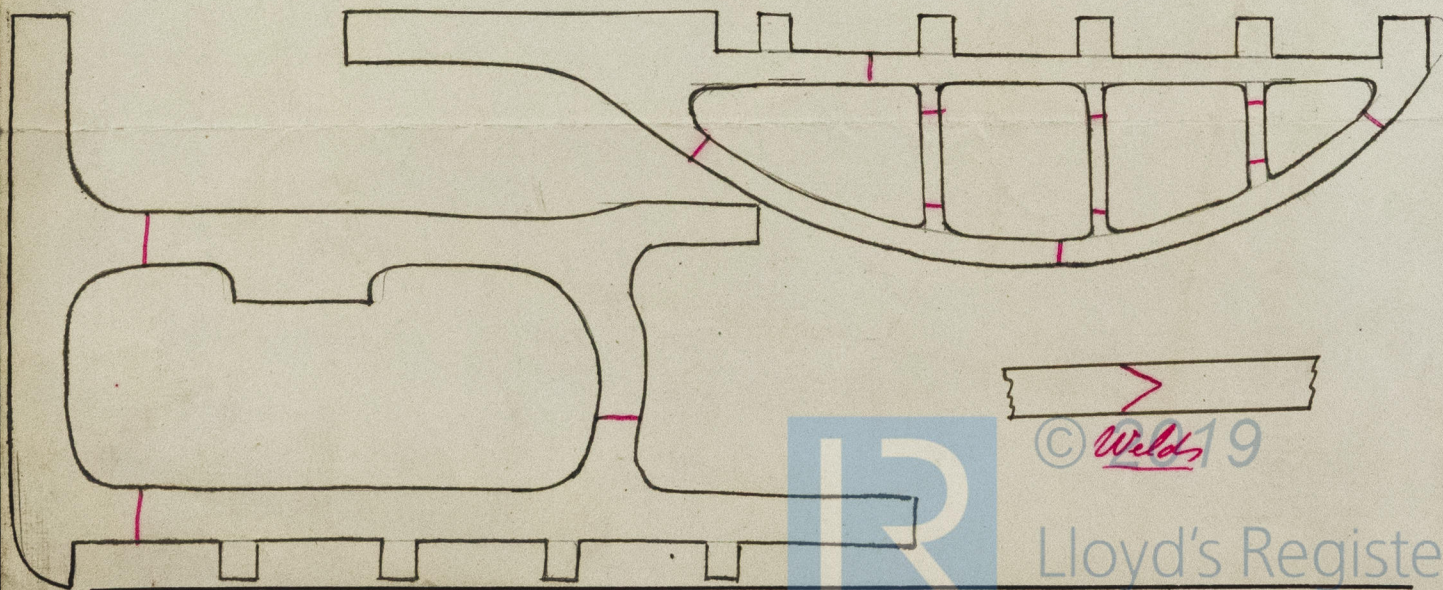

* If of Iron, state whether scrap or puddled Iron.

67

Ship forgings on
Stern and Rudder frame

Bel 17-4-90

"City of Dundee"

Bel Rpt 3441



© 2019

Lloyd's Register
Foundation