


— Arrangement Amidships of beams & deck plating No. 67 S. S. —
— Scale $\frac{1}{4}$ inch = one foot. —

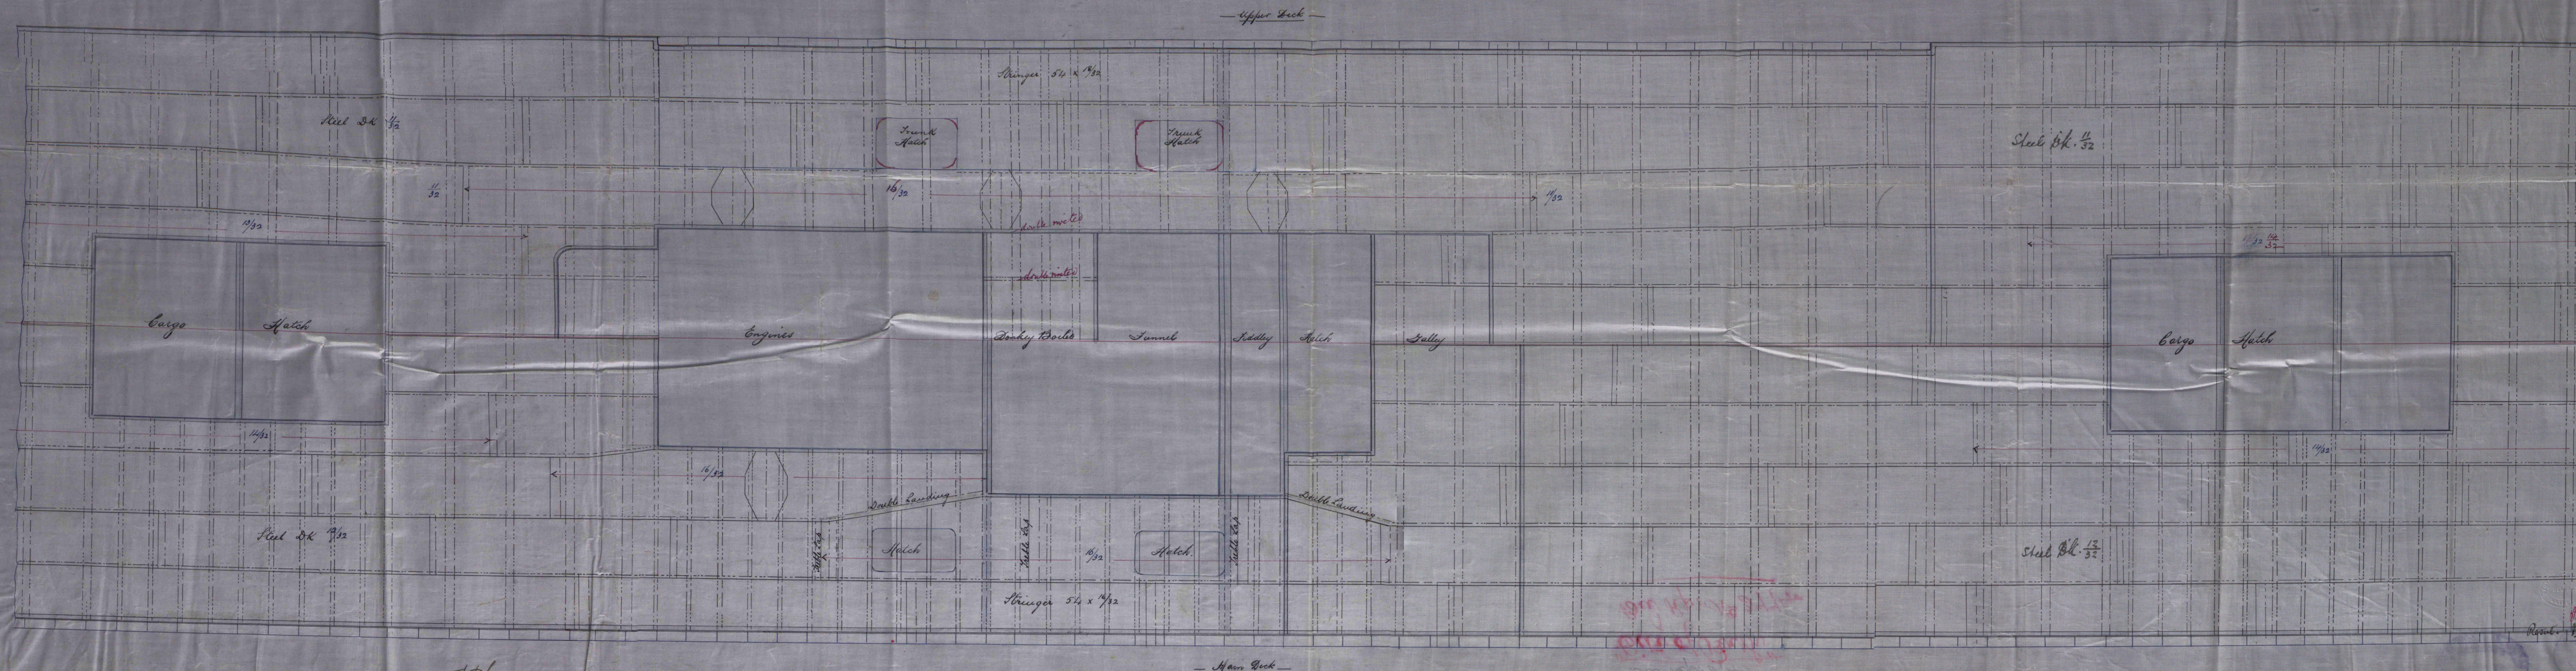

29/4/89

BEL57-0114

City of Dundee

Bel Rpt 3441

"City of Perth"

Bel Rpt No 3441

2190 88 $\frac{35}{12}$



© 2019

Lloyd's Register
Foundation