
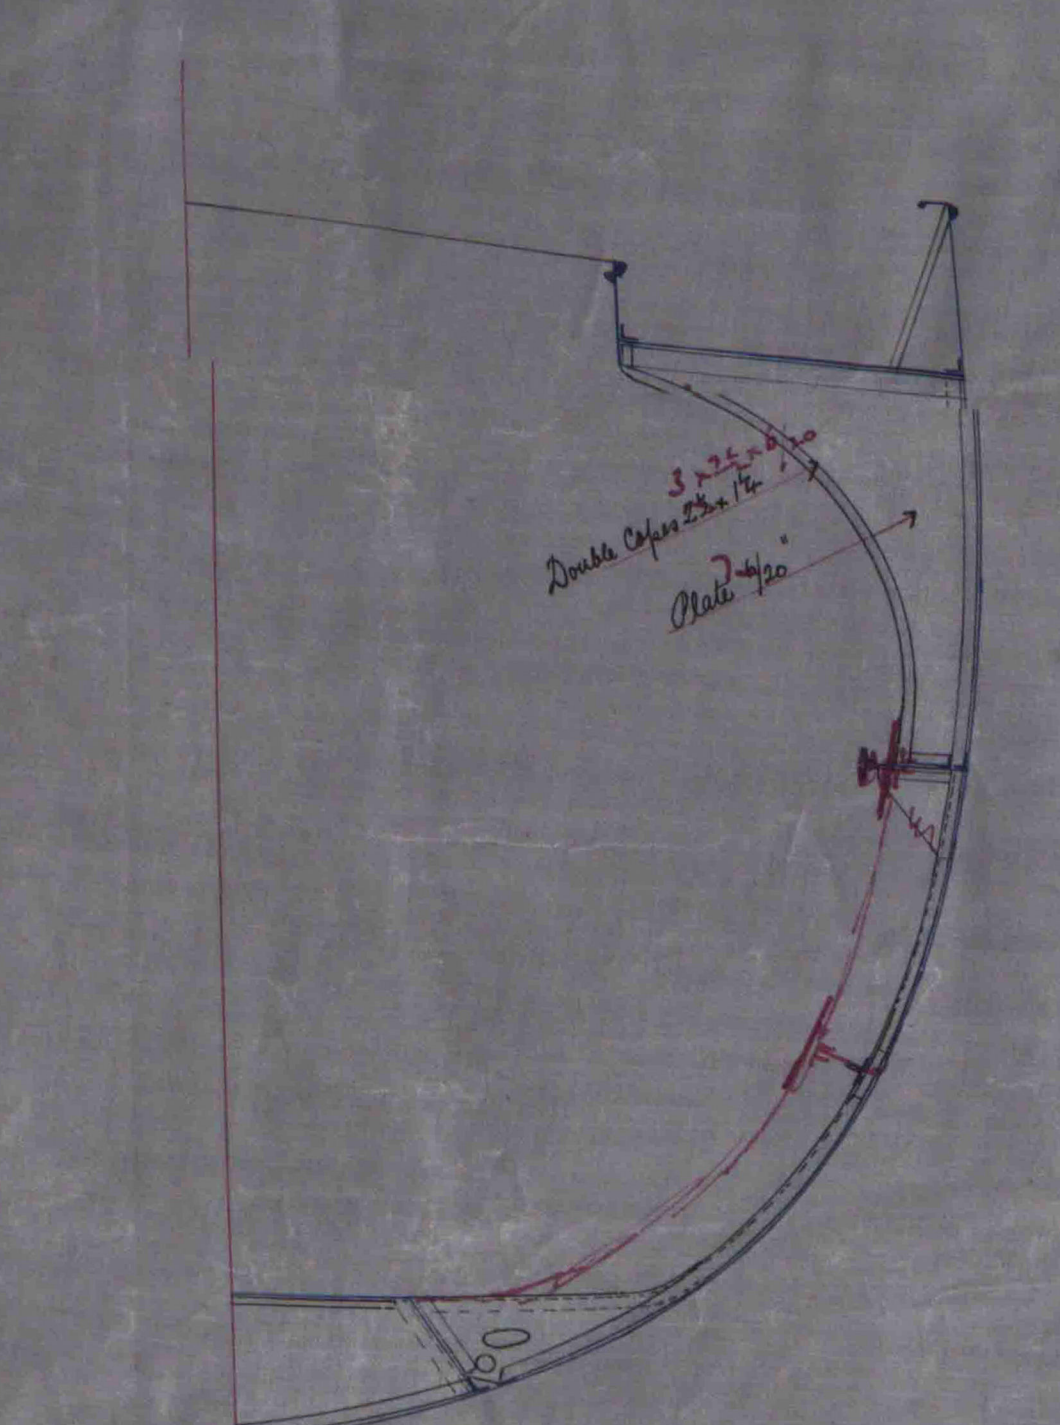
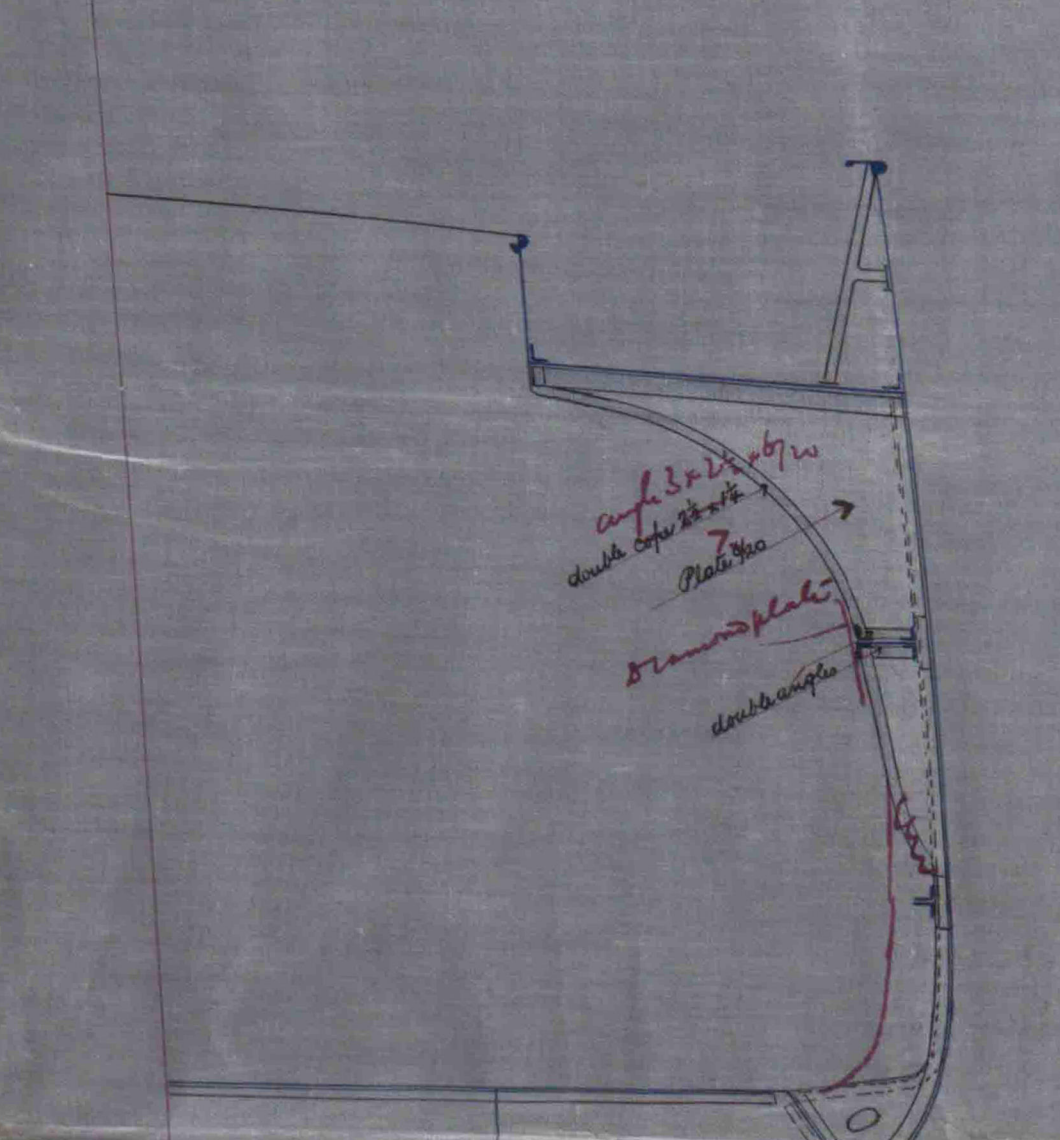




V.L.D. 17 AUG 89
M.D.L. 1911 (V. 3)

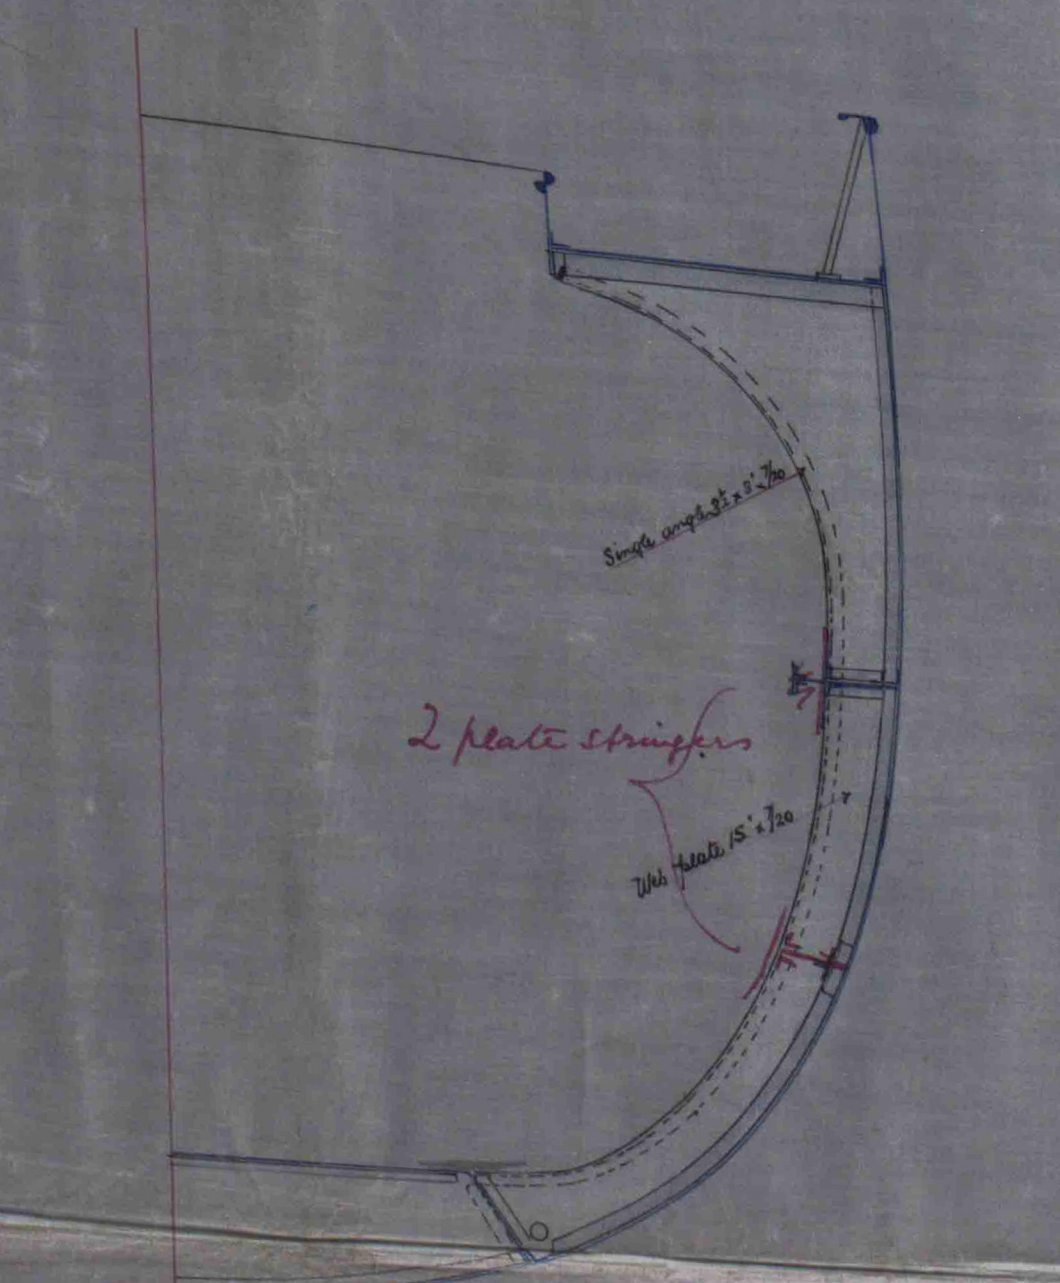

Section through No. 3 Hatch
Showing web frame

BE 57-0153

Longitudinal Section & Main & Quarter Deck Plans No. 70 S.S.
Scale 1/4 inch = One Foot
S.S. "Harley" Rel. Rpt. 5/61

  



On 20-4-89

JAL
30/4/89

BEL57-0158

S S Marlay
Bel Rpt No 34/61

no. 34/61
A

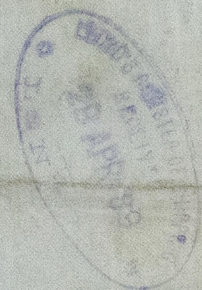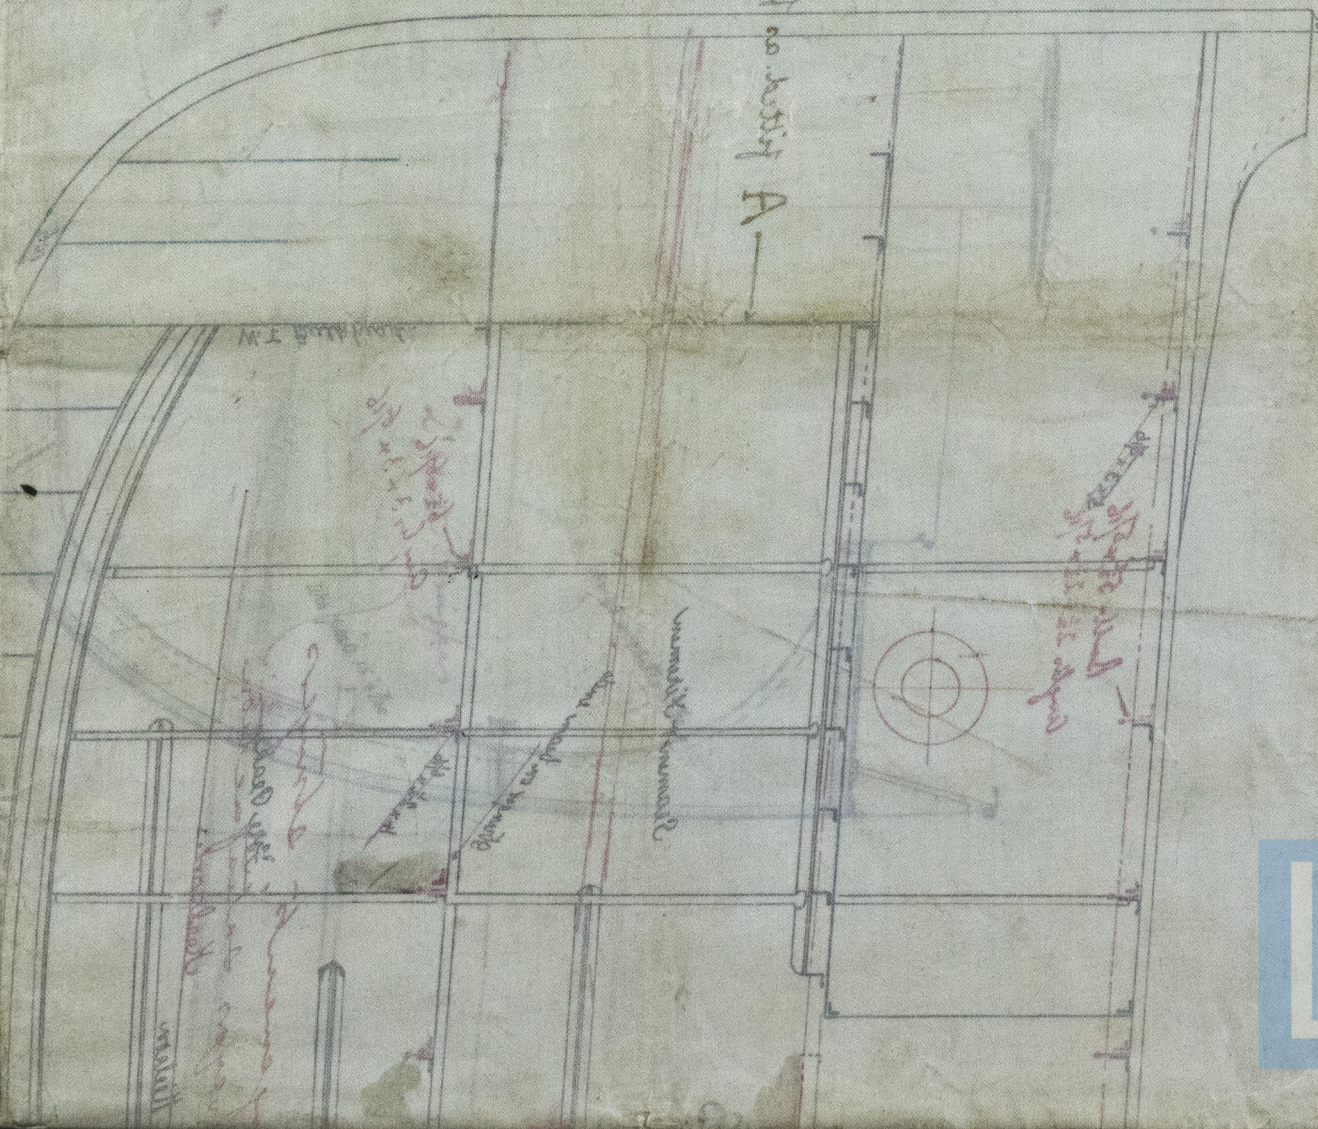

© 2019

Lloyd's Register
Foundation