


Mr 13/5/90

Pumping Arrangement No. 70 S.S.


Scale 1/8 inch = one foot.

S.S. "Harley" Bel Rpt 3461


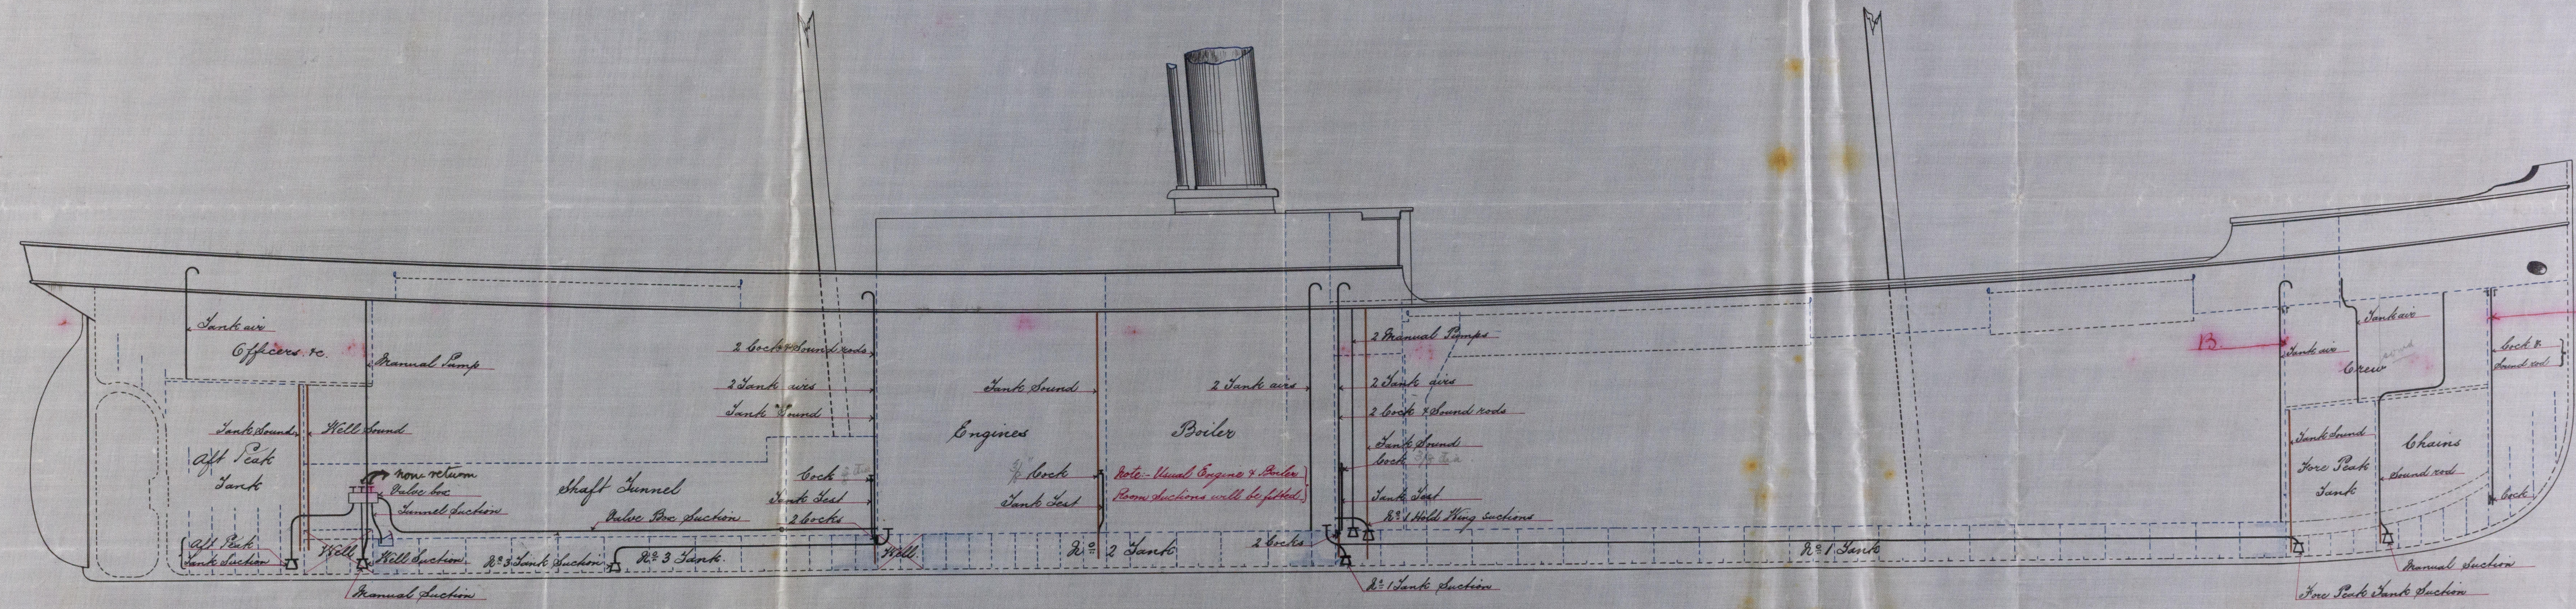


A. fitted as per Rule for W.S. Release

A.L.D.  
12.5.90

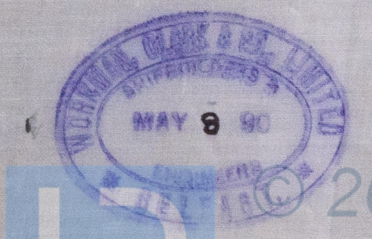



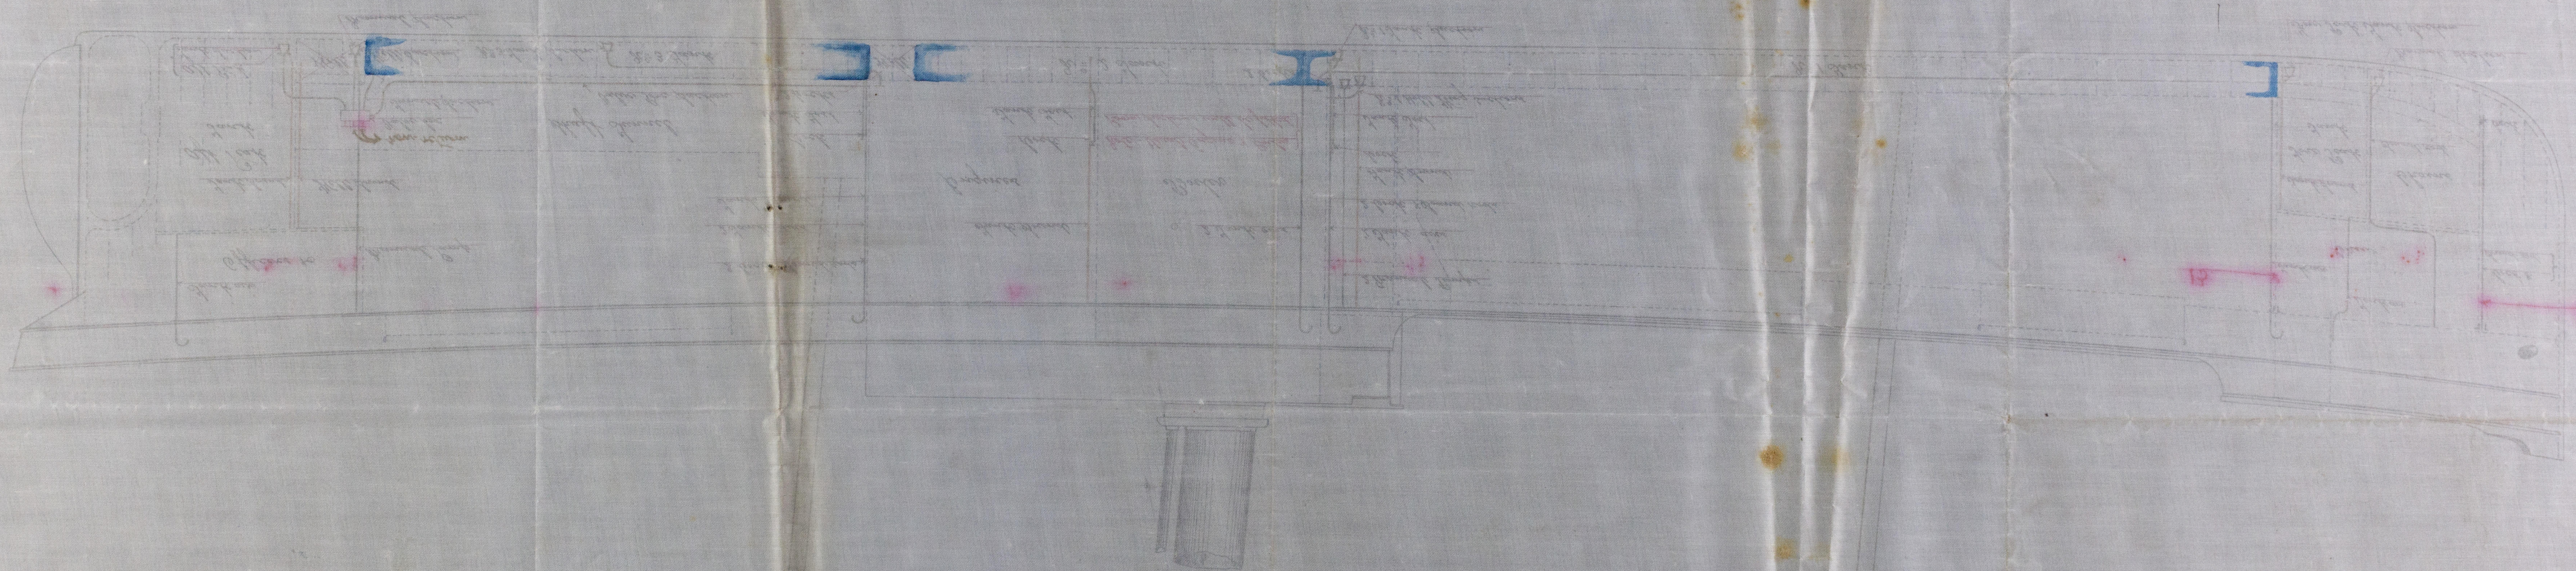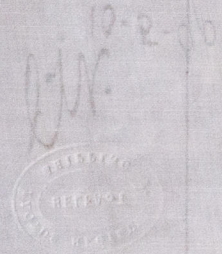

J. S. McArthur  
Dec 20 18 2/4

BA 57-01607



© 2019  
Lloyd's Register  
Foundation


