

MIDSHIP SECTION

STEEL S.S. 370' X 44' X 30.6" KEEL TO BEAMS

Nº 231.

TO CLASS 100 A1 AT LLOYDS

THREE DECK RULE

-POOP BRIDGE & FORECASTLE

SCALE $\frac{1}{2}$ " = ONE FOOT

NUMERALS

$$\underline{22.0 + 30.5 + 47.92 - 7.0 = 93.42} \quad \text{FRAMING N}^\circ$$


93.42 x 368.16 = 34,393 PLATING N°

$$100.42 \times 368.16 + 4167 \frac{1}{2} = 41,597 \quad \text{EQUIPMENT}$$

8.36 Breadths 12.06 Depths to Length 16.33 Depths (to Middle deck)

TO BEAMS _____
Duplicate of No 227. Michigan

Mississippi
Belfast Report
No 3490

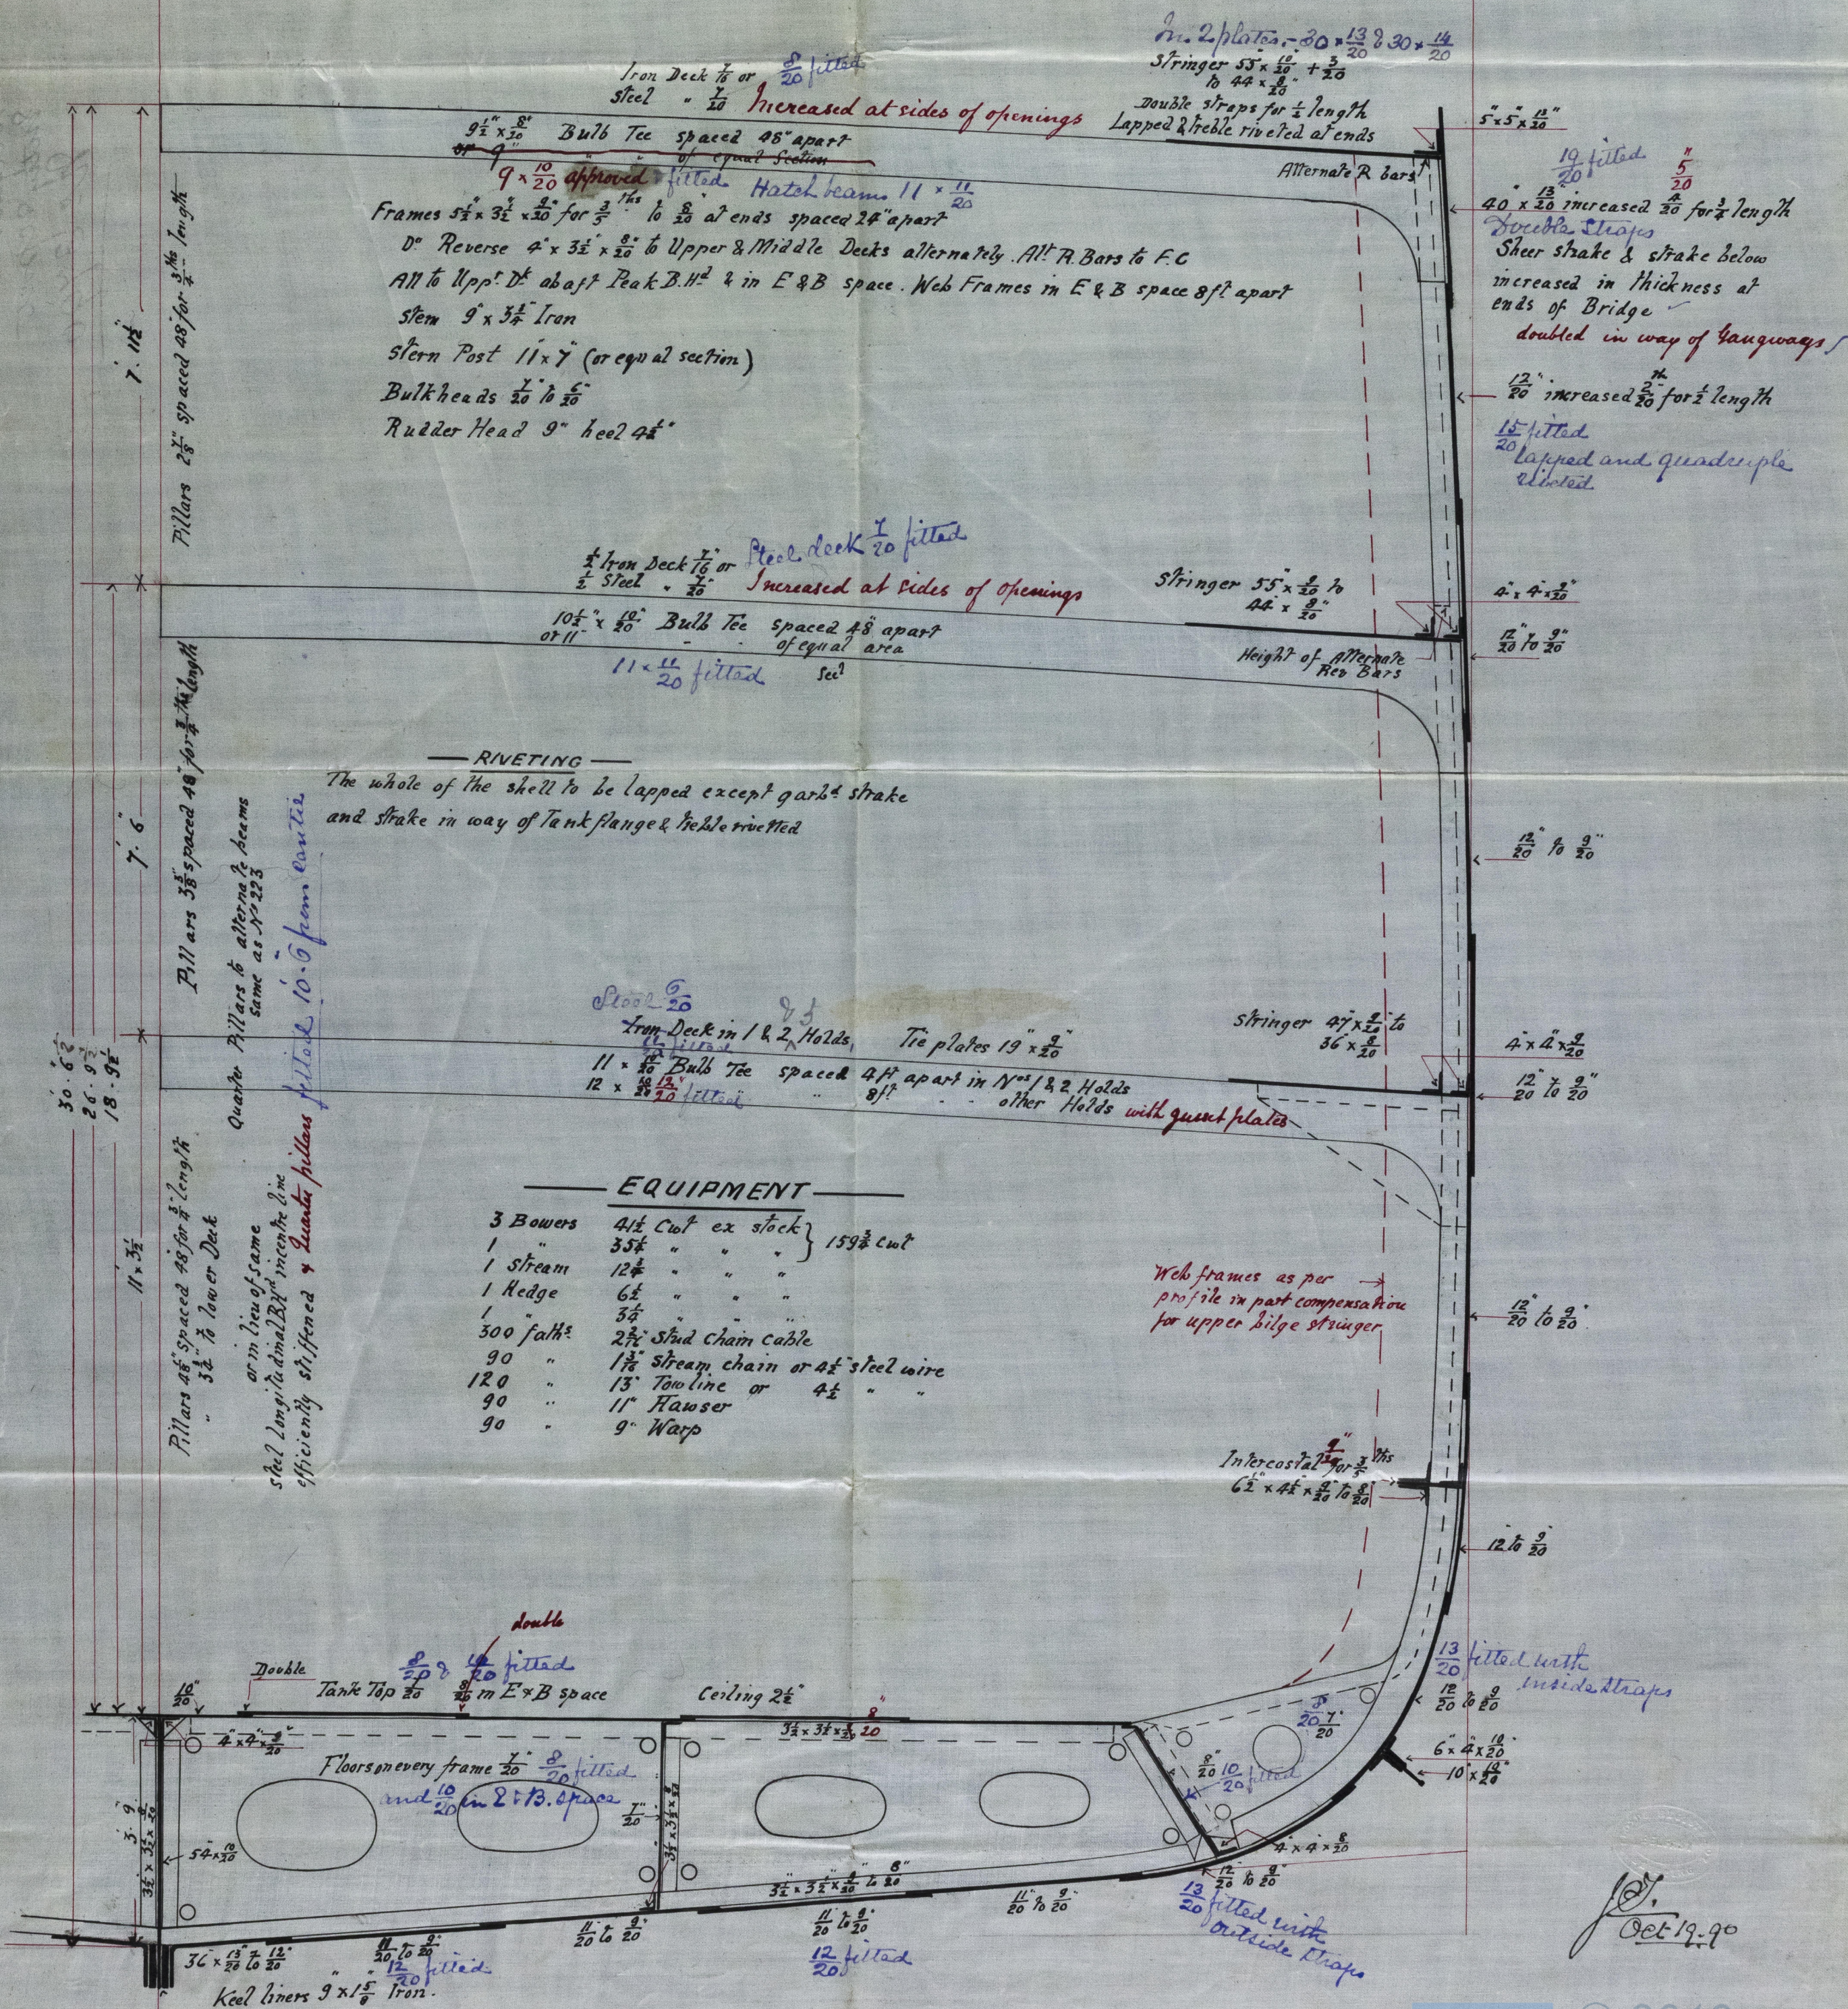

Oct 19. 90

Mississippi
Belfast First
Entry report
No 3490

© Lloyd's Register
Foundation