

Received at Belfast Office, 5th June, 1890

Lloyd's Register of British and Foreign Shipping.

Belfast

(Report on Vessel No. 3792 Port Belfast)

vs Ethelwold.

No. 1438.a

SHIP FORGINGS OR CASTINGS.

The words FORGINGS or CASTINGS, IRON or STEEL, should be struck out as may be required.

I have to report that the undermentioned Iron ~~or Steel~~ Forgings or Castings, manufactured by The Darlington Forge Co. of Darlington for the Vessel No. Y2, being built by Mrs Warkman Clark Co. of Belfast have been inspected by me as set forth below, and found to be, so far as can be seen, sound


Mark on Forgings.

Lloyd's
No. 1438.a
L.C.

Wm Cameron
Sunderland

	STERN FRAME.	RUDDER FRAME.	STEM.
Material*	<u>Scrap iron</u>	<u>Scrap iron</u>	
How made	<u>Forged</u>	<u>Forged</u>	
Dimensions	<u>7 x 4 1/2"</u>	<u>4 3/4" - 2 3/4"</u>	
Progress on Inspection	<u>Smithed</u>	<u>Forged Smithed</u>	<u>Not seen</u>
Dates when Inspected	<u>Aug 21-31 Sept 4/89</u>	<u>May 2.9-13-20-22/90</u>	

SKETCHES OF FRAMES SHEWING POSITION AND DESCRIPTION OF WELDS OF FORGINGS, OR PARTICULARS OF TESTS APPLIED TO CASTINGS.

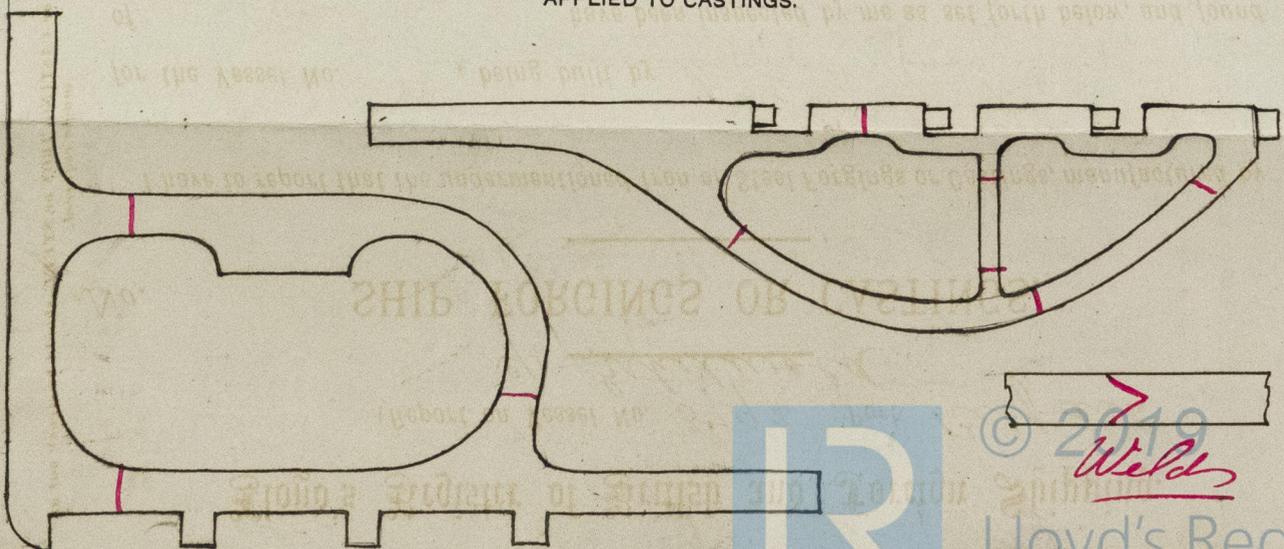

Welds

Lloyd's Register
Foundation

* If of Iron, state whether scrap or puddled Iron.

43

Re-Forgings on Stern
& Rudder frame

5-6-90

To ~~the~~ Helwold

Bel Rpt N^o 3792



© 2019

Lloyd's Register
Foundation