

TINGS, IRON or STEEL, should be struck out as may be required.



STINGS.


SHIP ~~FORGINGS~~ OR CASTINGS.

Mark on Forgings.

J. Dykes.
Barroco.

	STERN FRAME.	RUDDER FRAME.	STEM.
Material* - - -	Siemens Martin		
How made - - -	Cast & Annealed		
Dimensions - - -			
Progress on Inspection -	Cast & Annealed		
Dates when Inspected	4 th & 10 th Nov 1890		

SKETCHES OF FRAMES SHEWING POSITION AND DESCRIPTION OF WELDS OF FORGINGS, OR PARTICULARS OF TESTS
APPLIED TO CASTINGS.

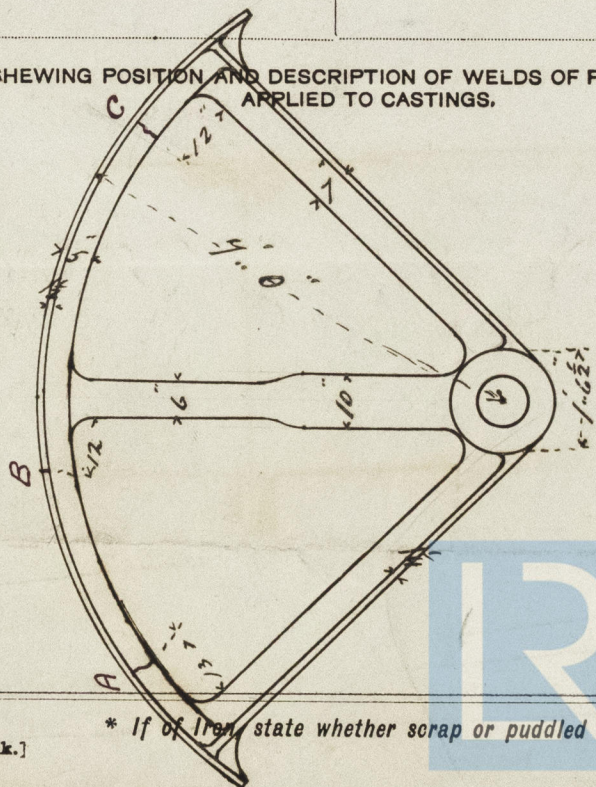

SECTION
AT C