

— S. S. N^o 43. —


Scale $\frac{1}{2}$ " = one foot.

140'-0" x 21'-6" x 12'-2" η^{LD} .

To Class 100A at Lloyds.

Steel shell iron scantlings.

MON 28 APR 90

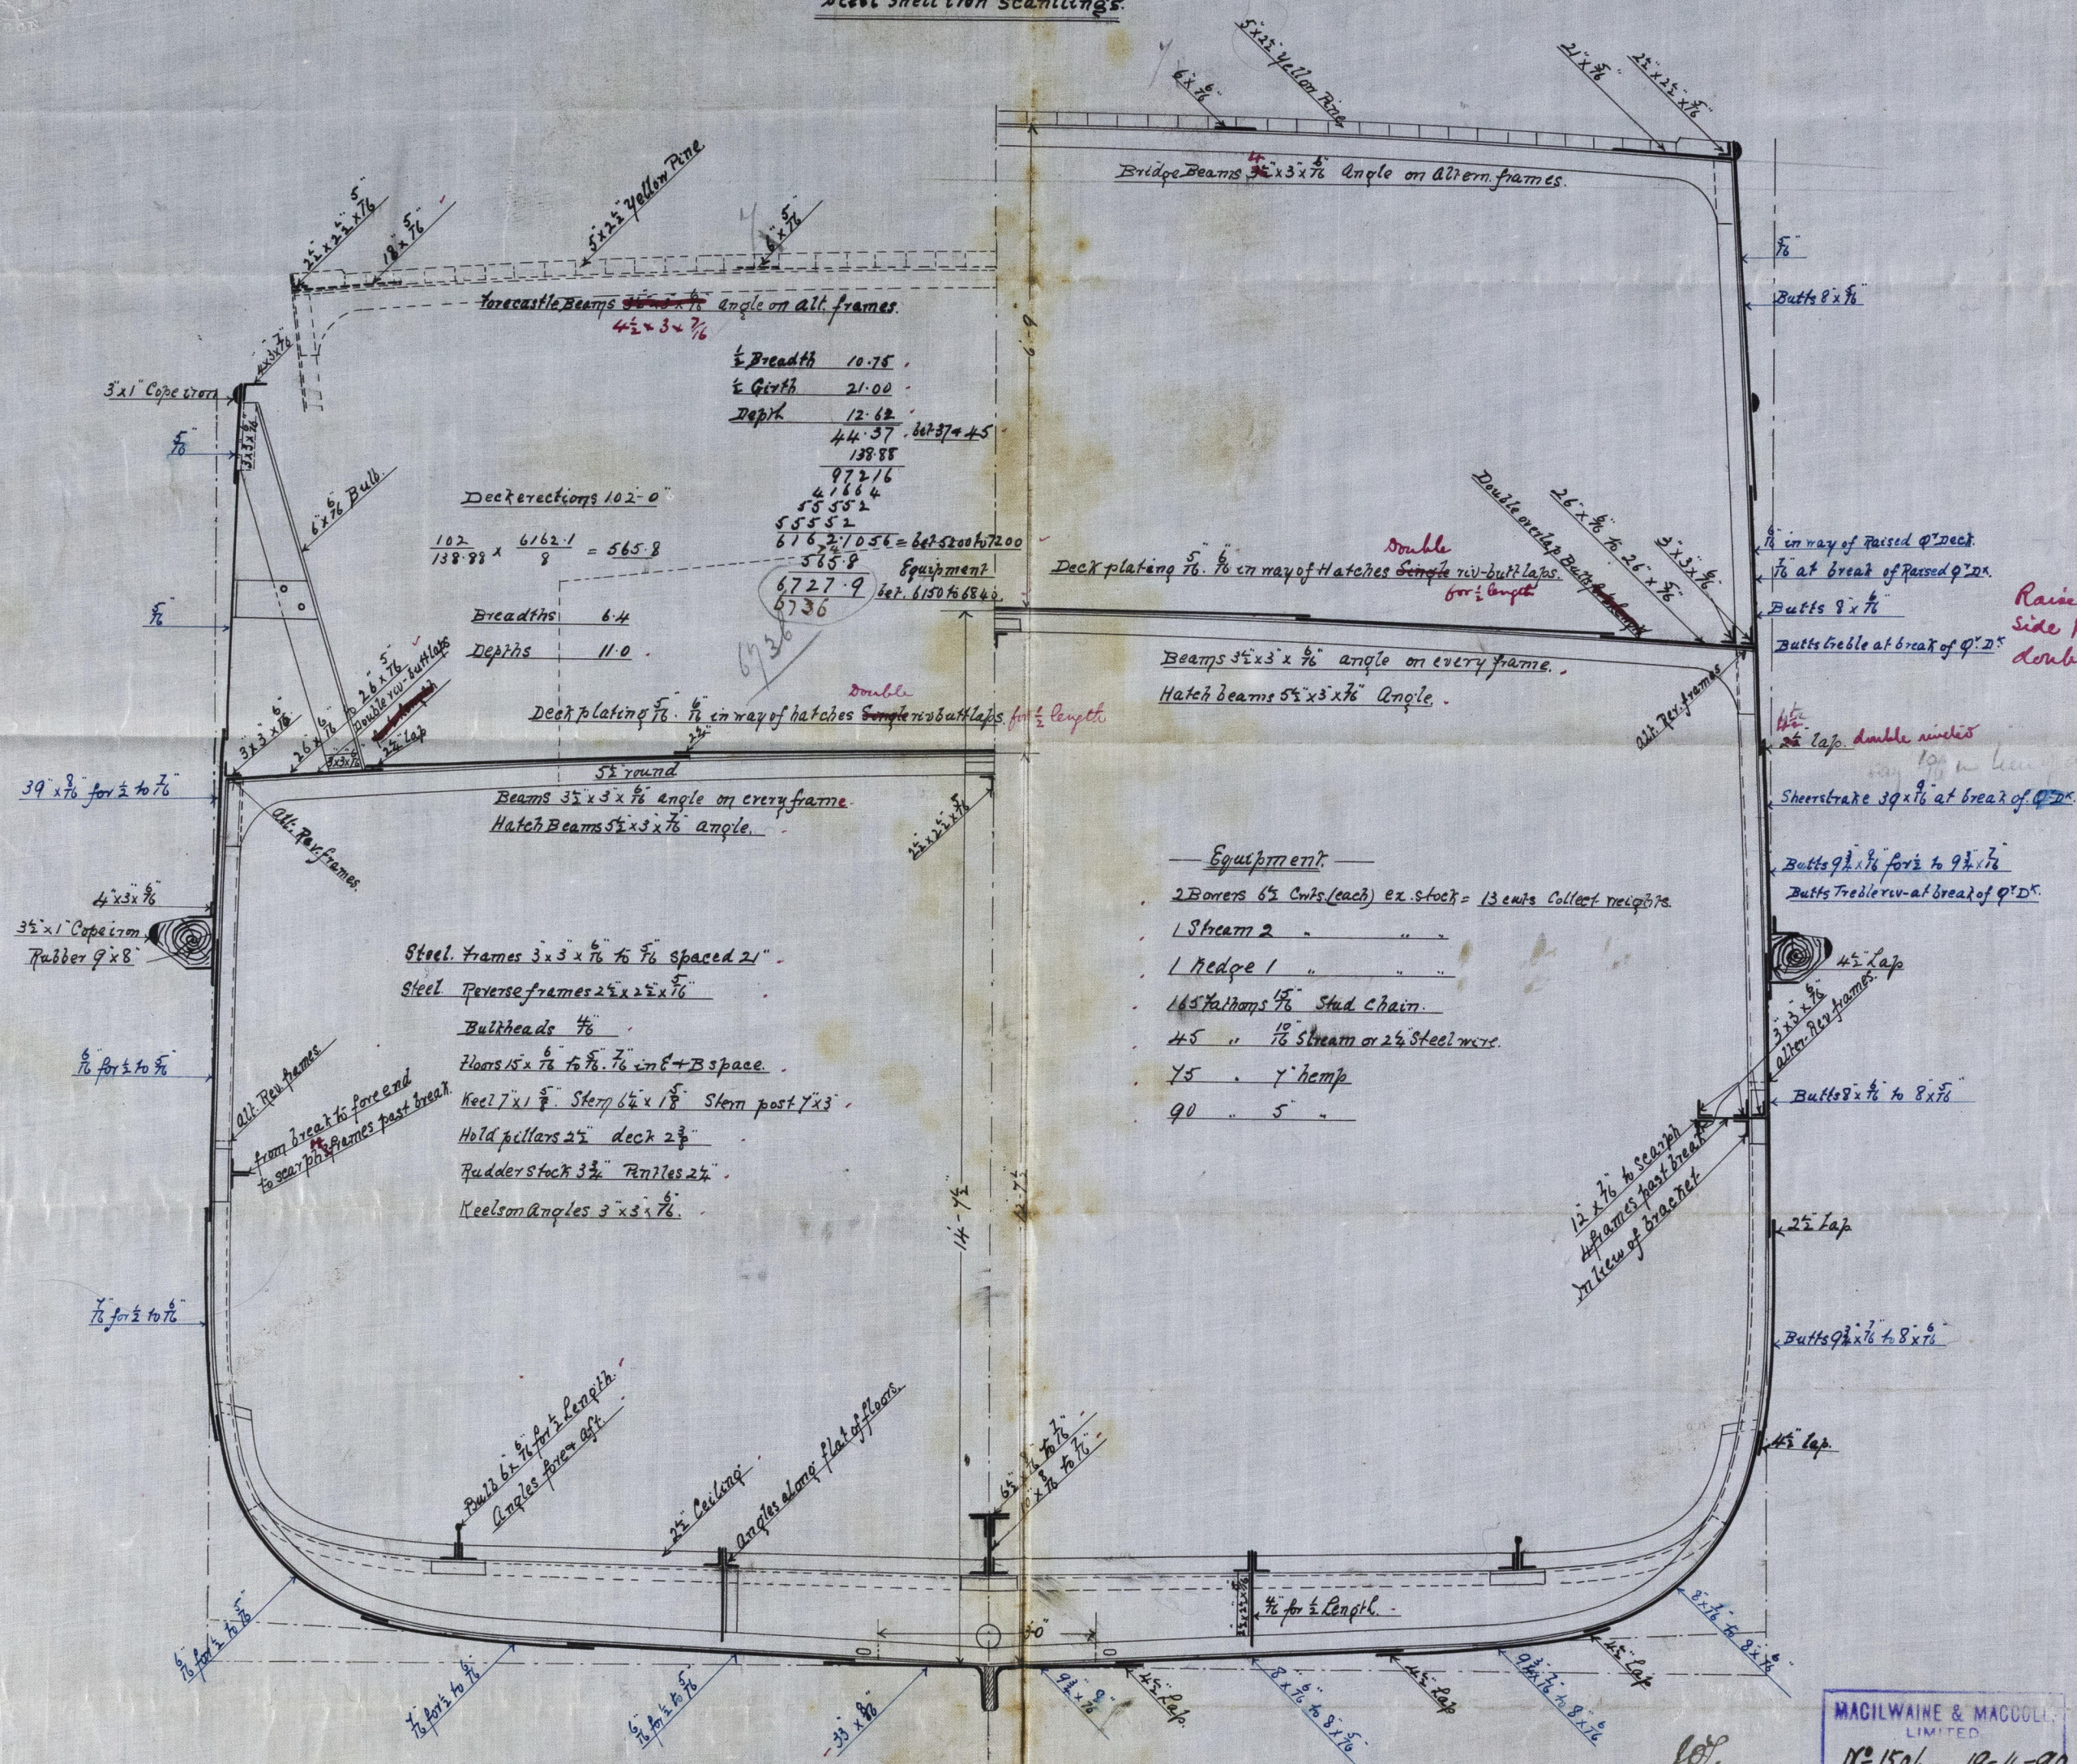

— Egyptian —

2 Bowers 6 1/2 Cnts. (each) ex. stock = 13 cnts Collect neighbors.

Stream 2

1 Redoe 1 " " "

165 to 170 mm $\frac{15}{16}$ " Stud chain

45 $\frac{10}{12}$ Stream or 25" Steel wire

45 y. ham?

12. 1. 1950